

T10N-R01W-25_0000_MCS

470.19' SOUTH 66.0° EAST
OF THE N-W CORNER OF
N1/4 OF S-W 1/4 OF SEC. 25,
T10N, R1N, MONROE CO., IND

N50°-42'-30"E
162.77'

N73°-00'-30"E
102.77'

S07°-46'E
167.10'

1.23 AC
GILLILAND

N62°-43'E
255.20'

N27°-00'W
115.71'

S48°-06'W
264.00'


0.22 AC

16.63 AC

S120°-52'E
120.00'

ANDERSON ROAD

ROAD

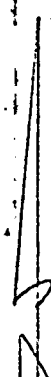

SCALE 1"=100'
O=IRON PIPE SET
●=IRON PIPE FOUND


FILED

MAR 23 1979


John W. Davis
Auditor Monroe County, Indiana

State of Indiana
County of Monroe SS:

I, Lee Utt, hereby certify that I am a Land Surveyor licensed in compliance with the laws of the State of Indiana; that the above plat and attached description correctly represents a survey completed by me on March 20, 1979; that all monuments shown thereon actually exist; and that their location and type are, to the best of my knowledge, accurately shown.

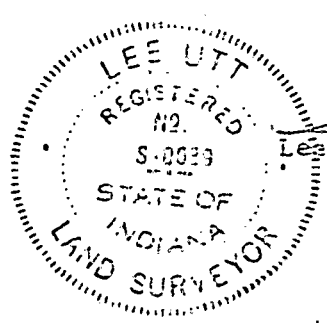

Lee Utt
Lee Utt, R. L. S. # 30089, Indiana
1604 South Henderson St.
Bloomington, Indiana 47401

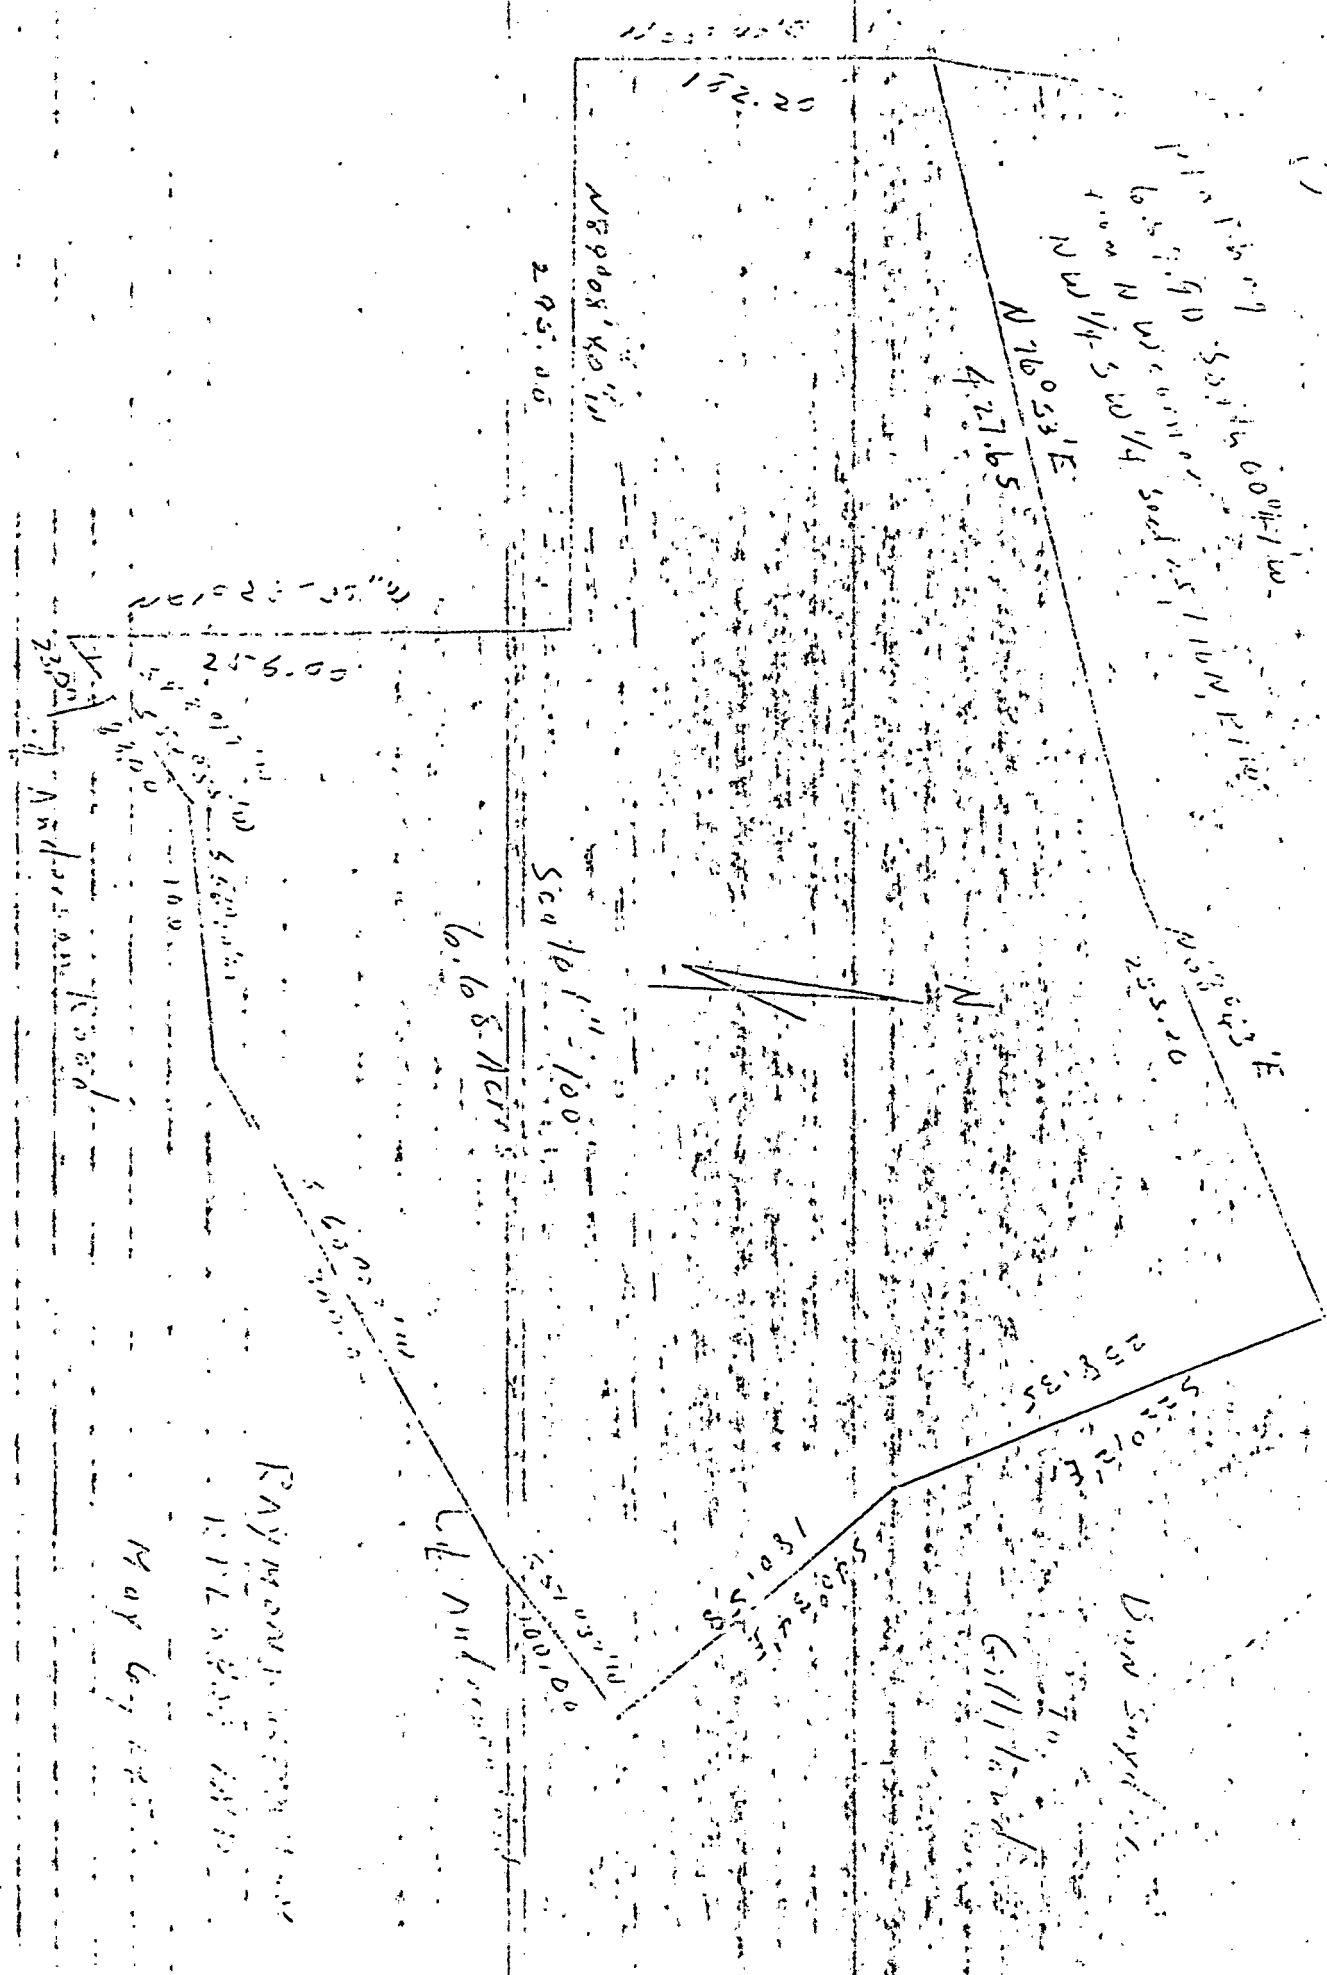

2-19-78 Sec 25
Causemore Robinson To
Cause Robinson


RAYMOND GRAHAM

3215 N. SMITH PIKE
BLOOMINGTON, INDIANA 47401


R.P.E. 6409 INDIANA
June 17, 1977

Causemore Robinson Description

A part of the Northwest quarter of the Southwest quarter of Section 25, Township 10 North, Range 1 West, Monroe County, Indiana described as follows: Beginning at a point that is 40.10 feet South of the Northeast corner of the said quarter quarter and in the centerline of Anderson Road, thence South 29 degrees 50 minutes West along the said road centerline for 509.42 feet; thence South for 838.71 feet to the South line of the said quarter quarter; thence East for 271.67 feet to the Southeast corner of the said quarter quarter; thence North along the East line of the said quarter quarter for 1279.90 feet and to the point of beginning. Containing in all 6.61 acres more or less. Subject to a 25.00 foot easement along the centerline of Anderson Road for County Highway right-of-way.

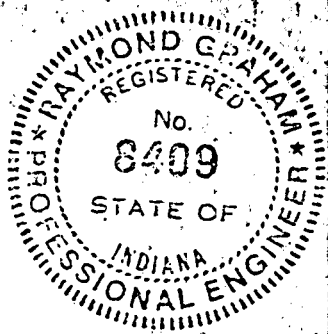

Raymond Graham

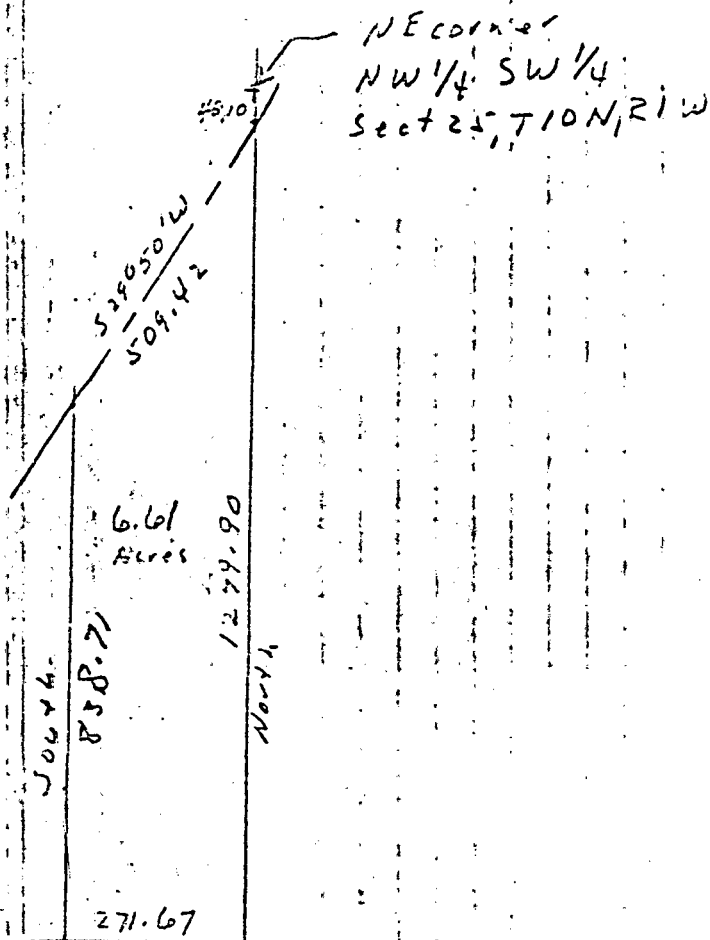

FILED

JUN 21 1977

Move to Gilliland

Sec 25

LEE UTT

REGISTERED LAND SURVEYOR No. S0089, INDIANA
OFFICE PHONE 332-8366 HOME PHONE 825-5961
1504 SOUTH HENDERSON
BLOOMINGTON, INDIANA 47401

March 20, 1979

Legal description:


Mr. & Mrs. Robert Gilliland

A part of the Northwest quarter of the Southwest quarter of Section 25, Township 10 North, Range 1 West, Monroe County, Indiana, bounded and described as follows:
Beginning at a point that is 476.19 feet South and 660.04 feet East of the Northwest corner of said Northwest quarter of the Southwest quarter, said point of beginning being also the Northeast-erly corner of a tract of land that is described in a deed from Edward and Mary Jane Hardin to Robert L. and Nancy J. Gilliland and recorded May 27, 1977, in Deed Record 251, page 98, in the office of the Recorder of Monroe County, Indiana; thence from said point of beginning and running North 50°-42'-30" East for 136.25 feet; thence North 77°-00'-30" East for 162.77 feet and to the centerline of Lydy Road; thence with the centerline of said road and running South 07°-46' East for 167.70 feet; thence leaving the centerline of said road and running South 48°-06' West for 264.00 feet and to a point on the Easterly line of the above referred to Gilliland tract; thence with the Easterly line of said Gilliland tract and running North 22°-20' West for 237.41 feet and to the point of beginning. Containing 1.33 acres, more or less.

FILED


MAR 23 1979


John W. Davis
Auditor Monroe County, Indiana

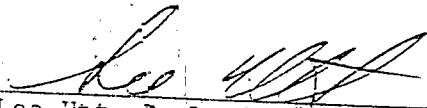
Lee Utt, P. L. S. # S0089, Indiana



are, to the best of my knowledge

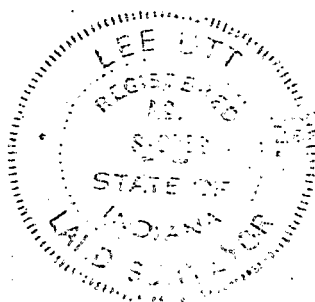


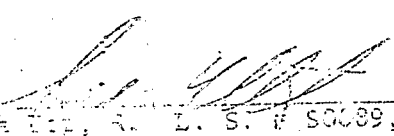
Lee Utt, P. L. S. # S0089, Indiana
1504 South Henderson St.
Bloomington, Indiana 47401

DITTEMORE PROPERTY

Roy Harris


Roy Harris

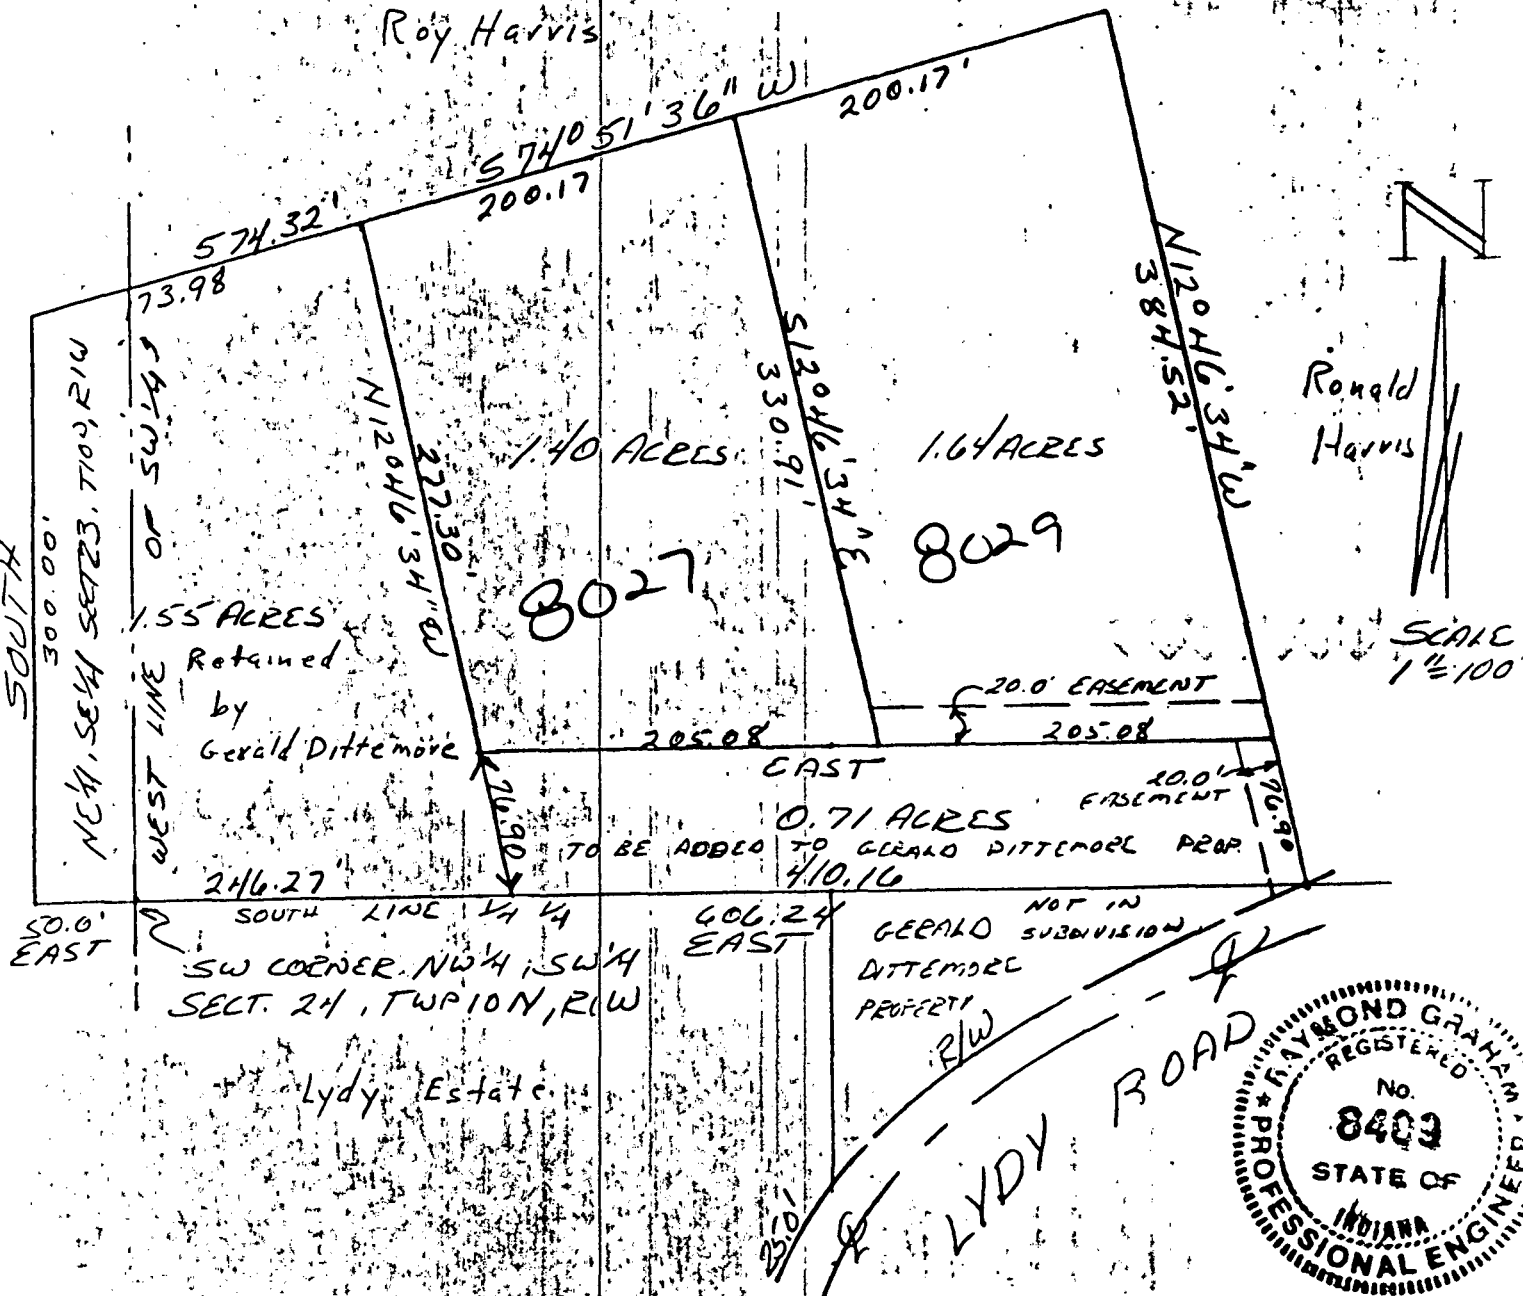

DESCRIPTION:

A part of the Northwest quarter of the Southwest quarter of Section 24 and a part of the Northeast quarter of the Southeast quarter of Section 25, all in Township 10 North, Range 1 East, Monroe County, Indiana, described as follows: Beginning at the Southwest corner of said Northwest quarter of the Southwest quarter of Section 24, thence East on and along the South line of said quarter quarter for 606.24 feet, thence leaving said South line and running North 12 degrees 46 minutes 34 seconds West for 461.42 feet, thence South 74 degrees 51 minutes 36 seconds West for 574.32 feet, thence South parallel to the East line of said Northeast quarter of the Southeast quarter of Section 23 for 300.00 feet and to the South line of said Northeast quarter of the Southeast quarter of Section 23, thence East on and along the South line of said quarter quarter for 50.00 feet and to the point of beginning. Containing in all 5.30 acres, more or less.


Raymond Graham
 Raymond Graham
 R.P.E. 8409 L.S. 9978 IND.
 June 1, 1981

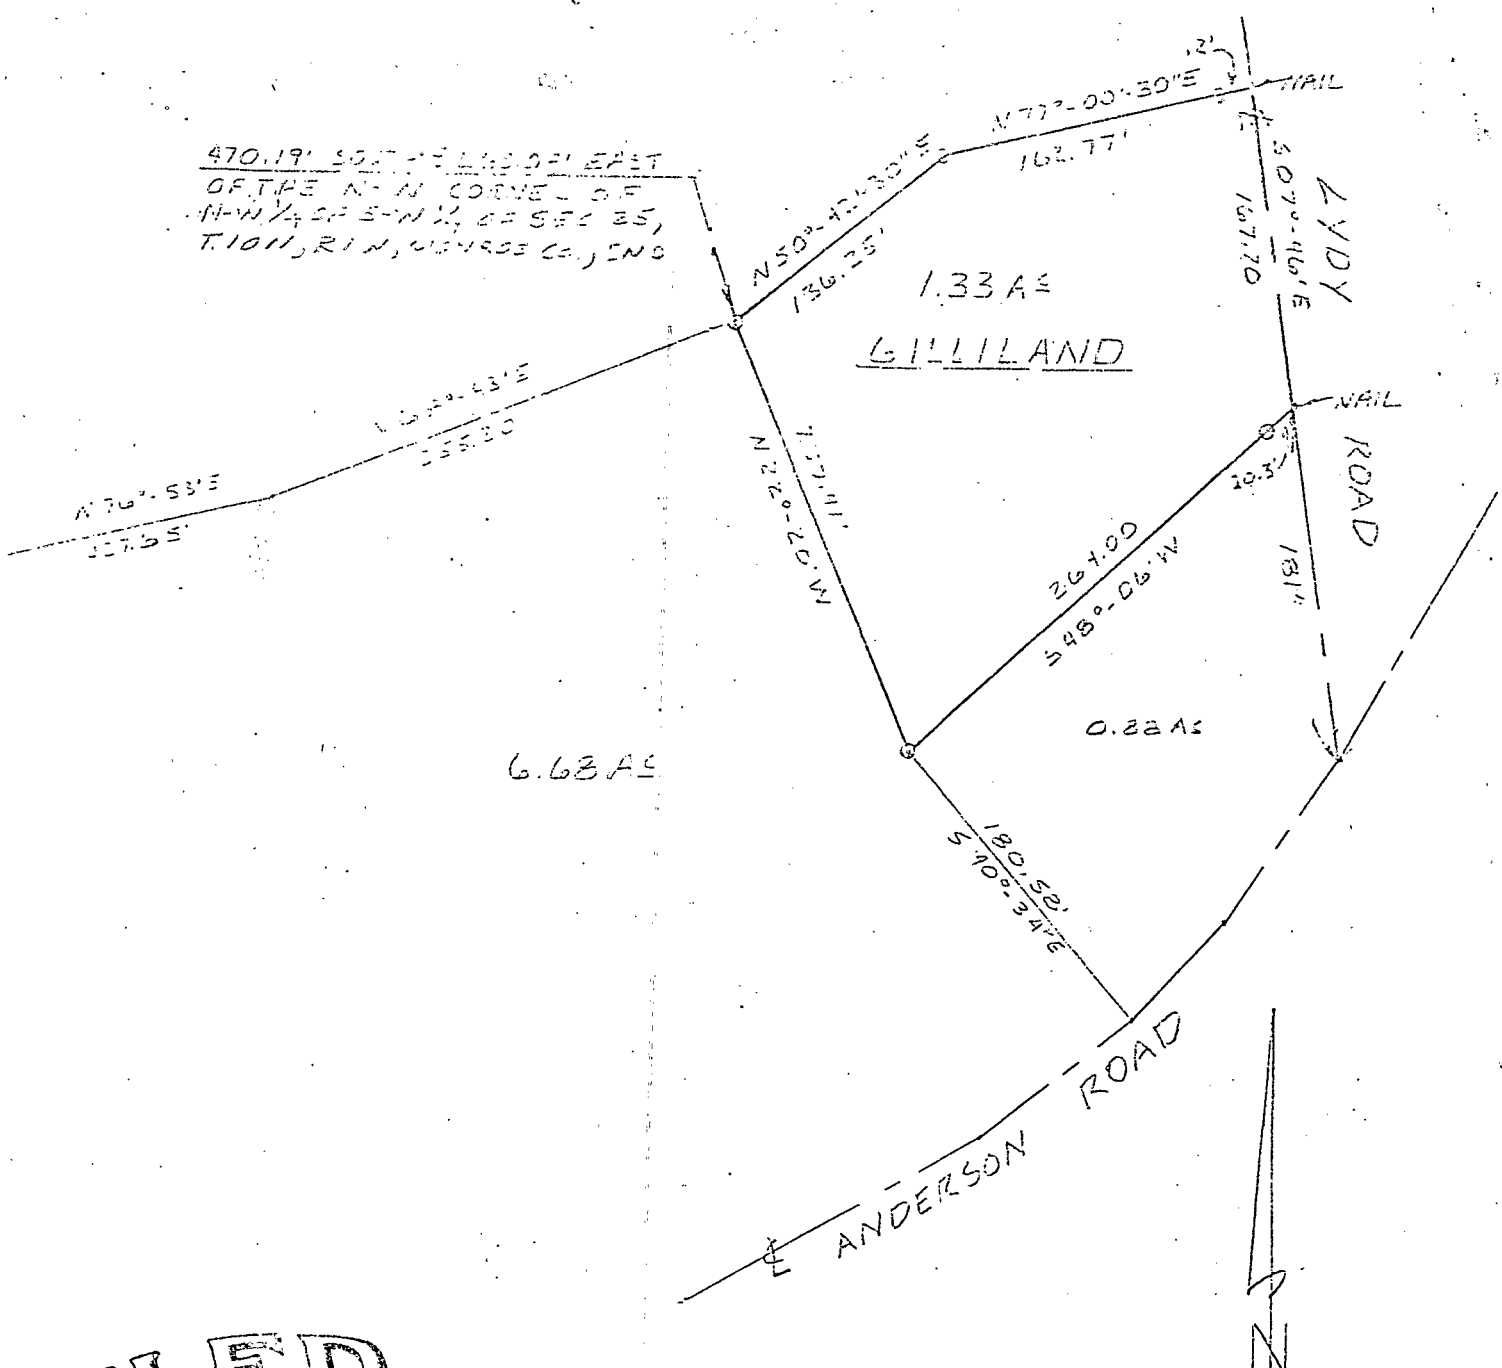

FILED
MAR 23 1979
John W. Davis
Auditor Monroe County, Indiana

State of Indiana
County of Monroe SS:

I, Lee Utt, hereby certify that I am a Land Surveyor licensed in compliance with the laws of the State of Indiana; that the above plat and attached description correctly represents a survey completed by me on March 20, 1979; that all monuments shown thereon actually exist; and that their location and type are, to the best of my knowledge, accurately shown.

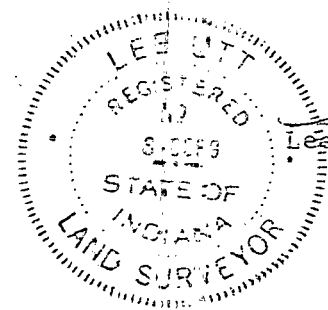


Lee Utt
Lee Utt, R. L. S. # S0089, Indiana
1604 South Henderson St.
Bloomington, Indiana 47401

Wach. Sec 25
Causemore Robinson To
Lesand Robinson


RAYMOND GRAHAM
3215 N. SMITH PIKE
BLOOMINGTON, INDIANA 47401
R.P.E. 8409 INDIANA
June 17, 1977

C.
Causemore Robinson Description

A part of the Northwest quarter of the Southwest quarter of Section 25, Township 10 North, Range 1 West, Monroe County, Indiana described as follows: Beginning at a point that is 40.10 feet South of the Northeast corner of the said quarter quarter and in the centerline of Anderson Road, thence South 29 degrees 50 minutes West along the said road centerline for 509.42 feet; thence South for 838.71 feet to the South line of the said quarter quarter; thence East for 271.67 feet to the Southeast corner of the said quarter quarter; thence North along the East line of the said quarter quarter for 1279.90 feet and to the point of beginning. Containing in all 6.61 acres more or less. Subject to a 25.00 foot easement along the centerline of Anderson Road for County Highway right-of-way.

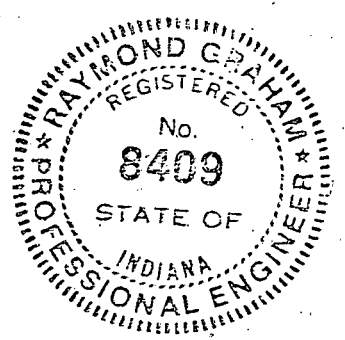

Raymond Graham

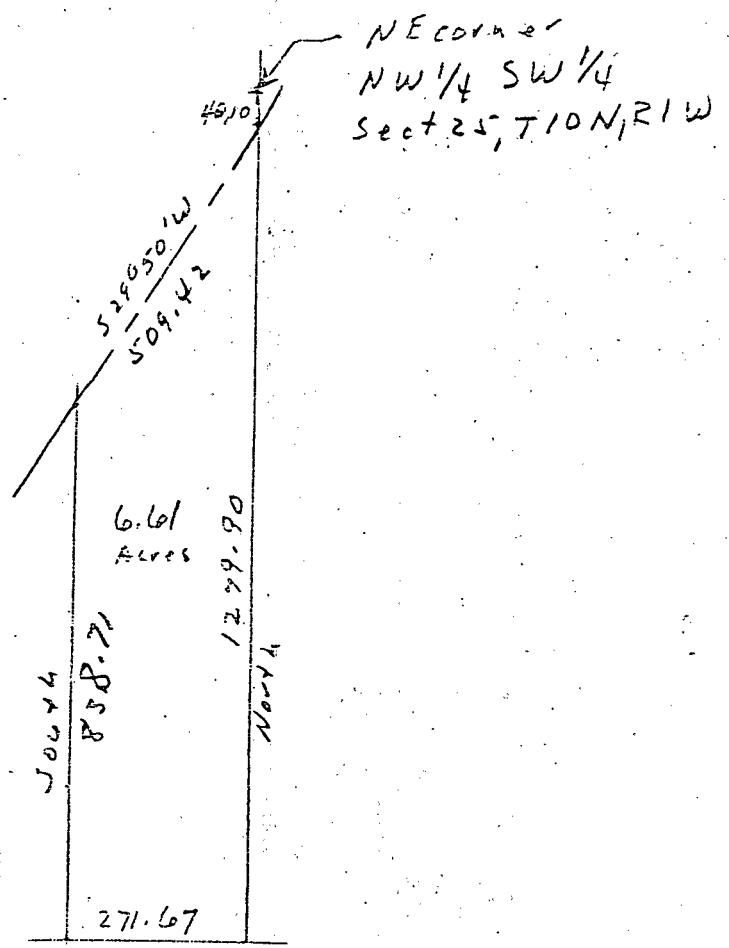

FILED
JUN 20 1977

County of Monroe, Indiana

[illegible]

86.9 30th 00 1/2 W
 659.90 SW corner
 1.00 N 1/4 SW 1/4 Sec 15 T 16 N, R 1 W
 NW 1/4 SW 1/4
 N 76° 53' E
 4.27.65
 22.281
 255.20
 N 66° 04' E
 238.35
 S 22° 12' E
 540° 34' E
 180.558
 Don Smith
 T¹⁰
 6/11

N8908' 40" N
295.00

~~SECRET~~


RAYMOND GORDON
REXHOF WYD
May 6, 1977

7350 1/2 Anderson Road

Washington



CONV. 5-17-75
Washington Imp. Dec 25

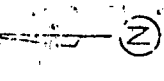

SCALE 1"=100'

C. 2.58 E.

PARCEL #4
5.038 ACRES

PARCEL #3
4.974 ACRES

PARCEL #2
5.137 ACRES

PARCEL #1
5.023 ACRES

PARCEL #5
1.227 ACRES

FOR ED HADDIN:

I CERTIFY THAT I AM A REGISTERED LAND SURVEYOR LICENSED UNDER THE LAWS OF INDIANA; THAT THE ABOVE SKETCH REPRESENTS A SURVEY MADE BY ME ON MAY 26, 1971; THAT THE MONUMENTS SHOWN ABOVE EXIST; AND THAT THEIR LOCATIONS, SIZES, TYPES AND MATERIALS ARE ACCURATELY SHOWN.

C. M. Pinnick
C. M. PINNICK R.L.S. # 5008

MAY 27, 1971



Washington

7/10/78 to 8/10/78 Sec 25

LEE UTT
REGISTERED LAND SURVEYOR NO. 80089, INDIANA
OFFICE PHONE 822-8266 HOME PHONE 822-8261
1724 SOUTH HENDRICKSON
BLOOMINGTON, INDIANA 47401


March 20, 1979

Legal description:

Mr. & Mrs. Robert Gilliland


A part of the Northwest quarter of the Southwest quarter of Section 25, Township 10 North, Range 1 West, Monroe County, Indiana, bounded and described as follows:

Beginning at a point, that is 470.19 feet South and 560.04 feet East of the Northwest corner of said Northwest quarter of the Southwest quarter, said point of beginning being also the Northeast-erly corner of a tract of land that is described in a deed from Edward and Mary Jane Hardin to Robert L. and Nancy J. Gilliland and recorded May 27, 1977, in Deed Record 251, page 98, in the office of the Recorder of Monroe County, Indiana; thence from said point of beginning and running North 50°-42'-30" East for 136.25 feet; thence North 77°-00'-30" East for 162.77 feet and to the centerline of Lydy Road; thence with the centerline of said road and running South 07°-46' East for 167.70 feet; thence leaving the centerline of said road and running South 45°-06' West for 264.00 feet and to a point on the Easterly line of the above referred to Gilliland tract; thence with the Easterly line of said Gilliland tract and running North 22°-20' West for 237.41 feet and to the point of beginning. Containing 1.33 acres, more or less.

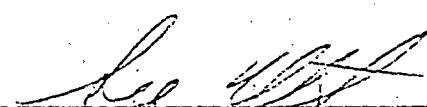
Lee Utt, R. L. S. # 80089, Indiana

FILED
MAR 23 1979


John H. Davis
Recorder of Monroe County, Indiana

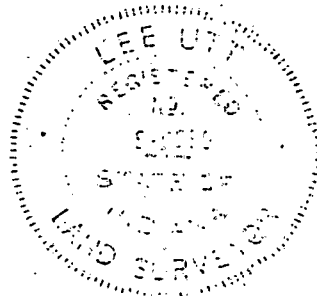

to the State of Indiana





John H. Davis
Recorder of Monroe County, Indiana
Bloomington, Indiana 47401

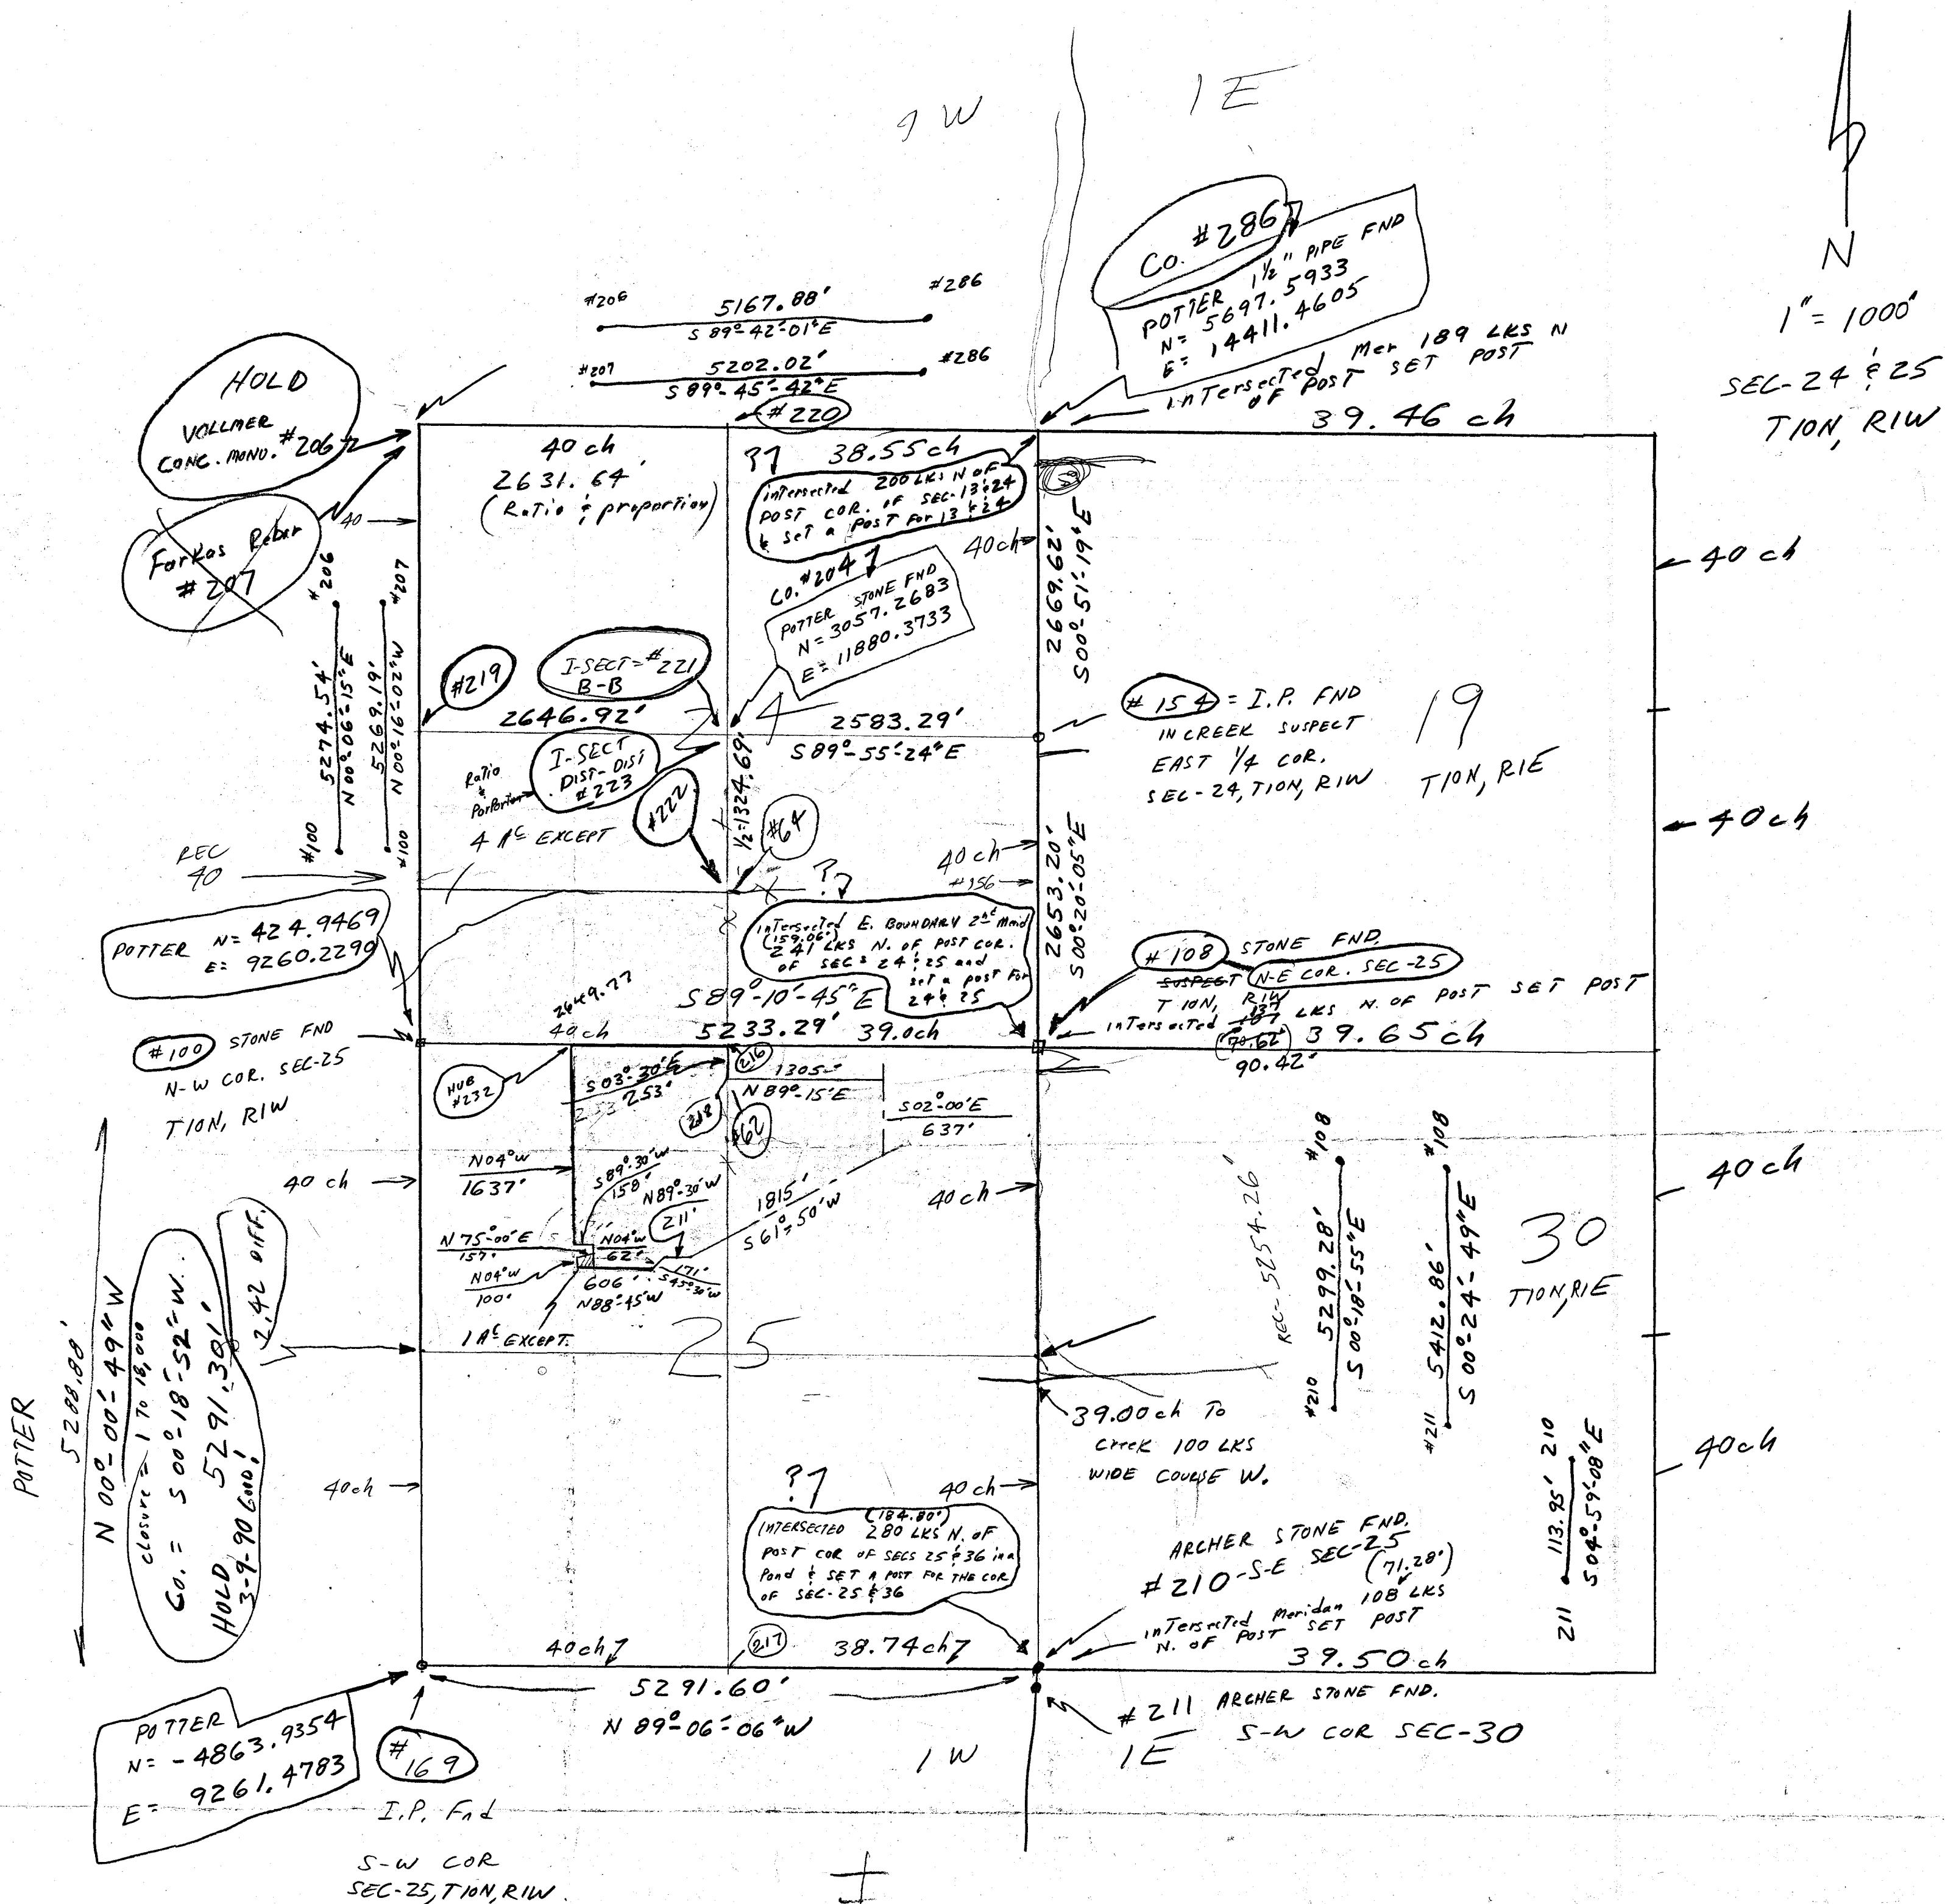


7-22-71
\$1.00 / FT.
DALE BURNETT


SECTION 24 - TOWNSHIP 10 NORTH - RANGE 1 WEST
WASHINGTON

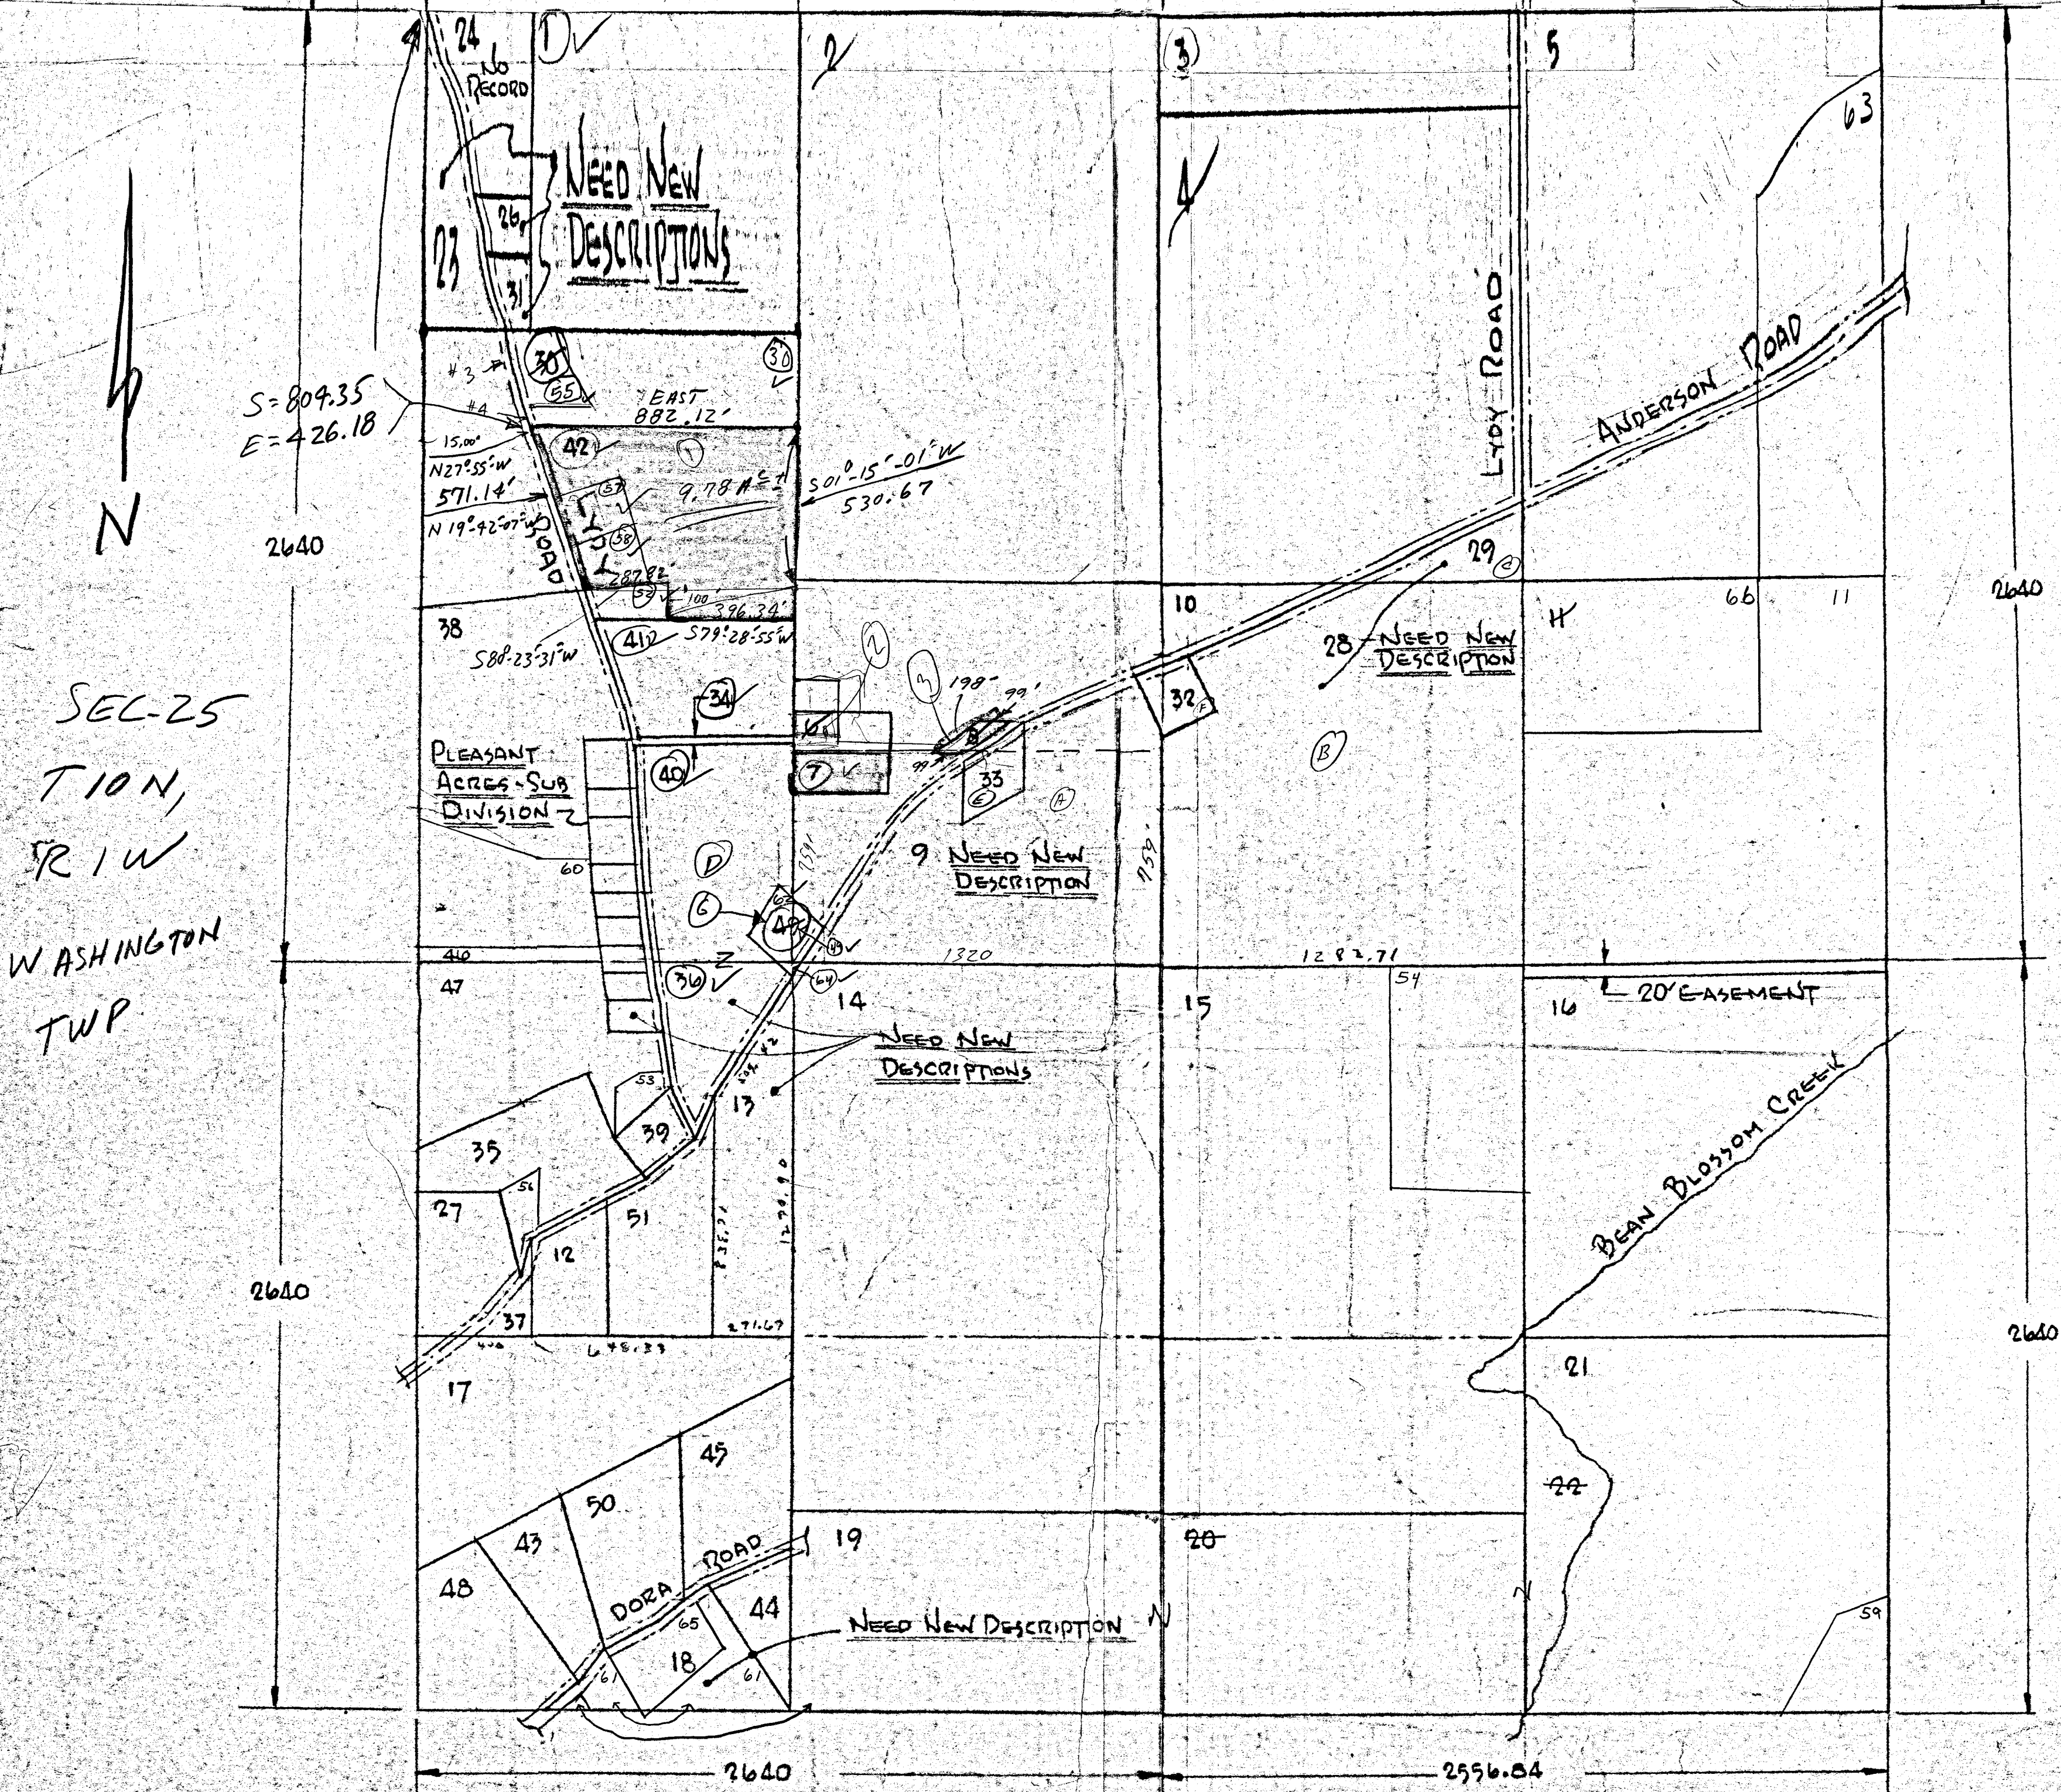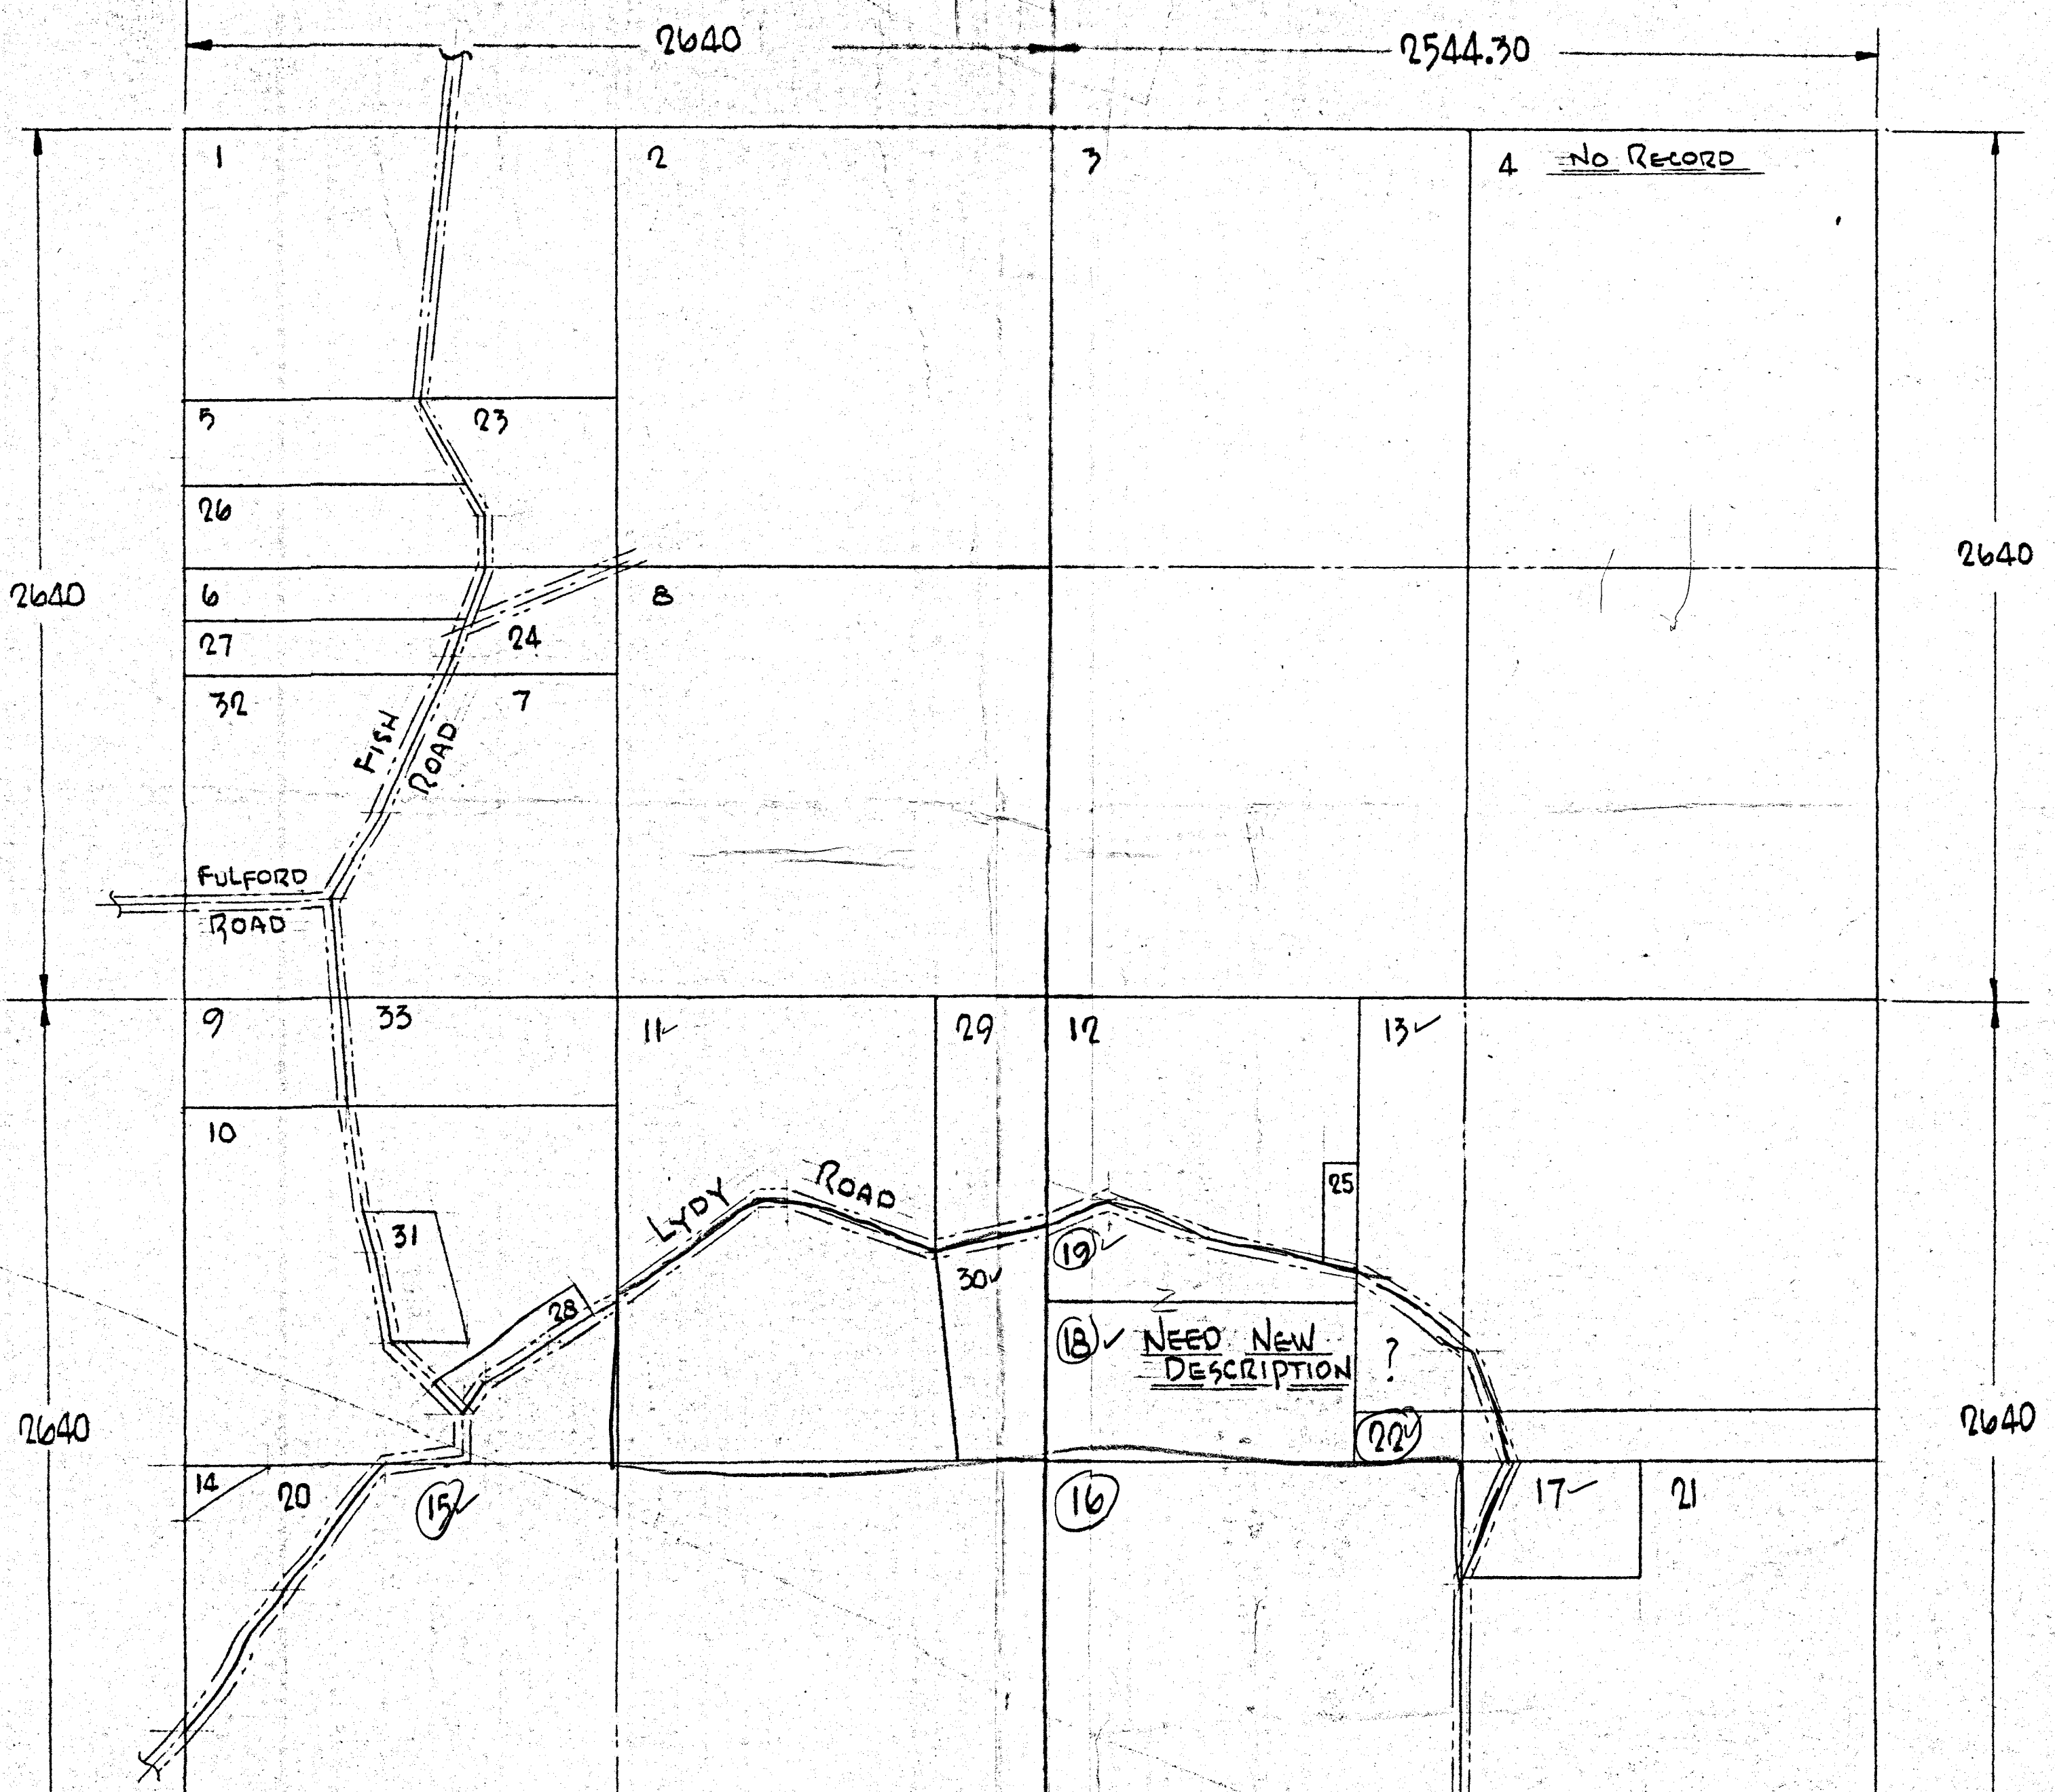

Sec 24 + 25

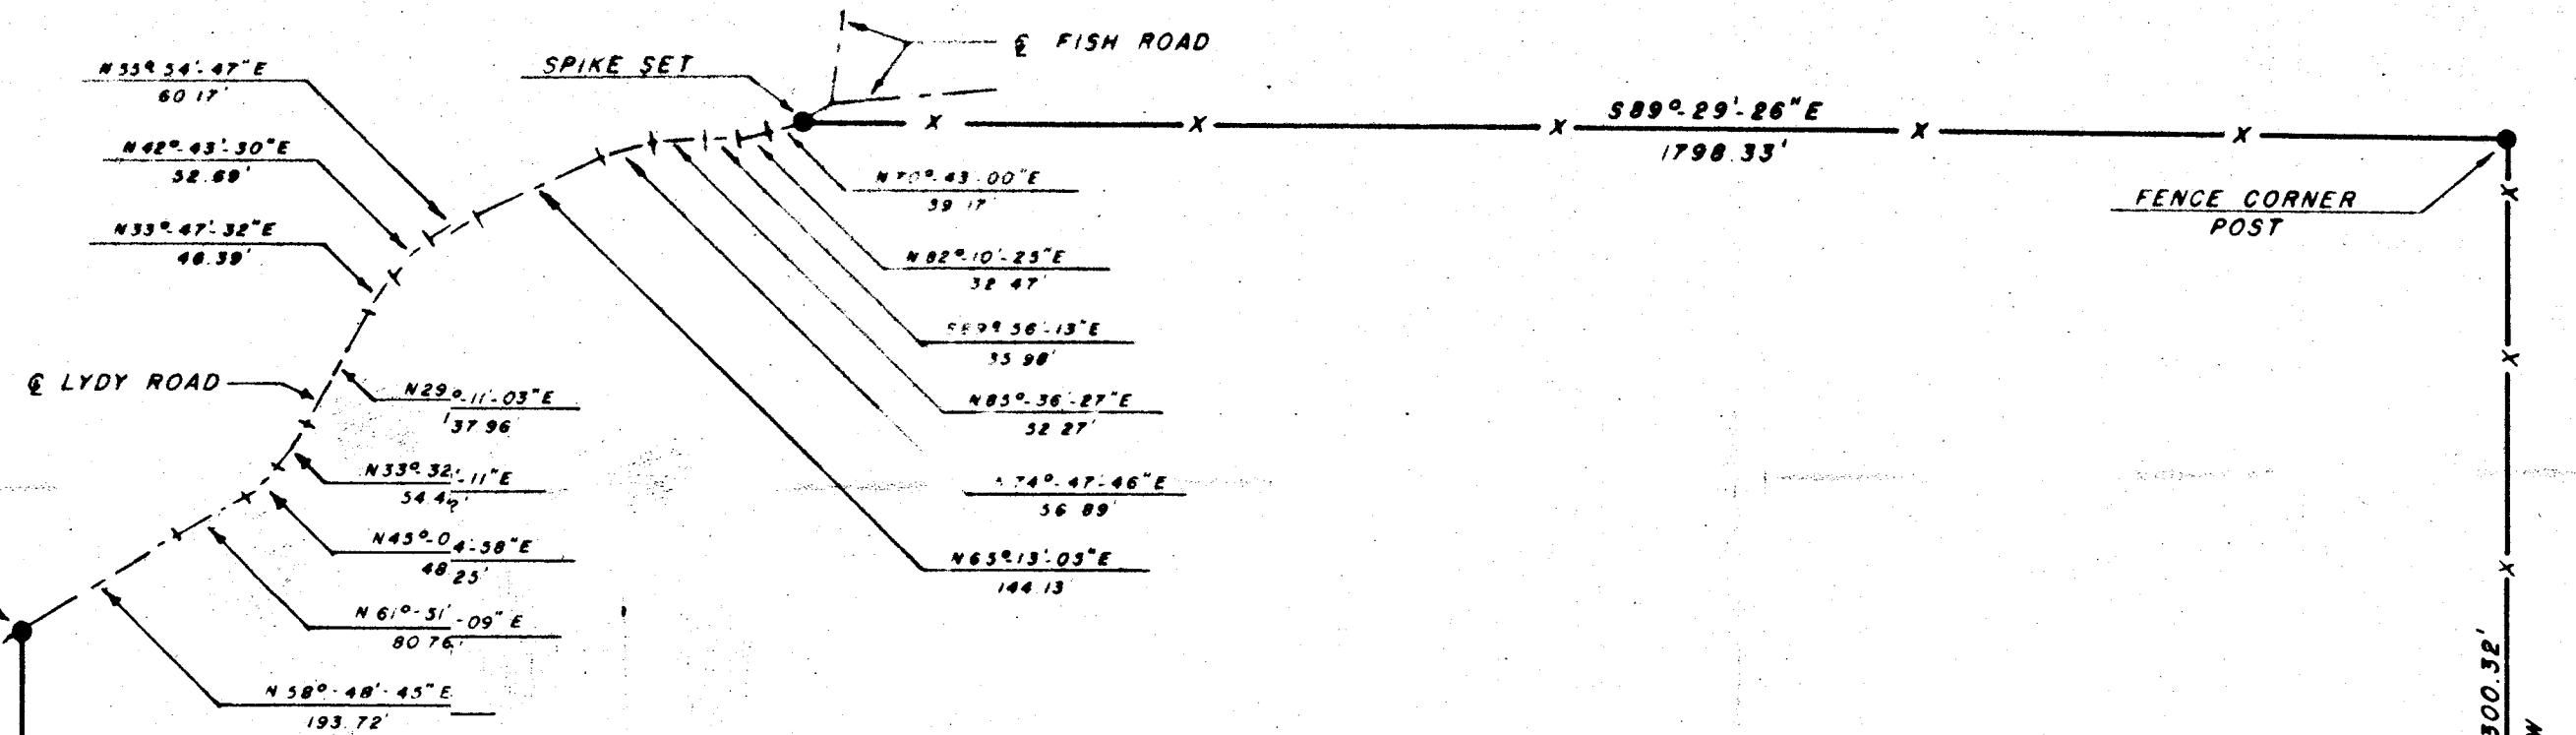

74.77 ± ACRES

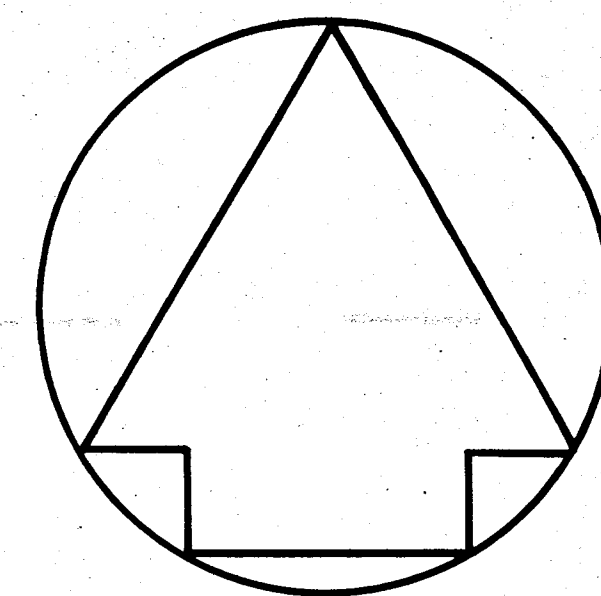

SCALE: 1" = 200'

—X—X— = EXISTING FENCE LINE
 --- = ROAD CENTERLINE

STONE FOUND: S-W CORNER OF
 SEC. 24, T-10-N, R-1-W
 MONROE COUNTY, IND.

1/2" REBAR SET: N-E CORNER
 OF N-W 1/4 OF SEC. 25, T-10-N,
 R-1-W, MONROE COUNTY, IND.

SEC. 24, T-10-N, R-1-W
 SEC. 25, T-10-N, R-1-W

1/2" REBAR SET: N-W CORNER
 OF THE EAST HALF OF THE N-W
 1/4 OF SEC. 25, T-10-N, R-1-W

EXISTING FENCE
 FENCE CORNER POST

SPIKE SET


MONROE COUNTY LANDFILL

74.77 ± ACRES IN SEC. 24
 82.67 ± ACRES IN SEC. 25
 157.44 ± ACRES TOTAL

82.67 ± ACRES

PLAT PREPARED BY:


Edmund O. Farkas
 EDMUND O. FARKAS
 MONROE CO. SURVEYOR
 R. L. S. No. S0114

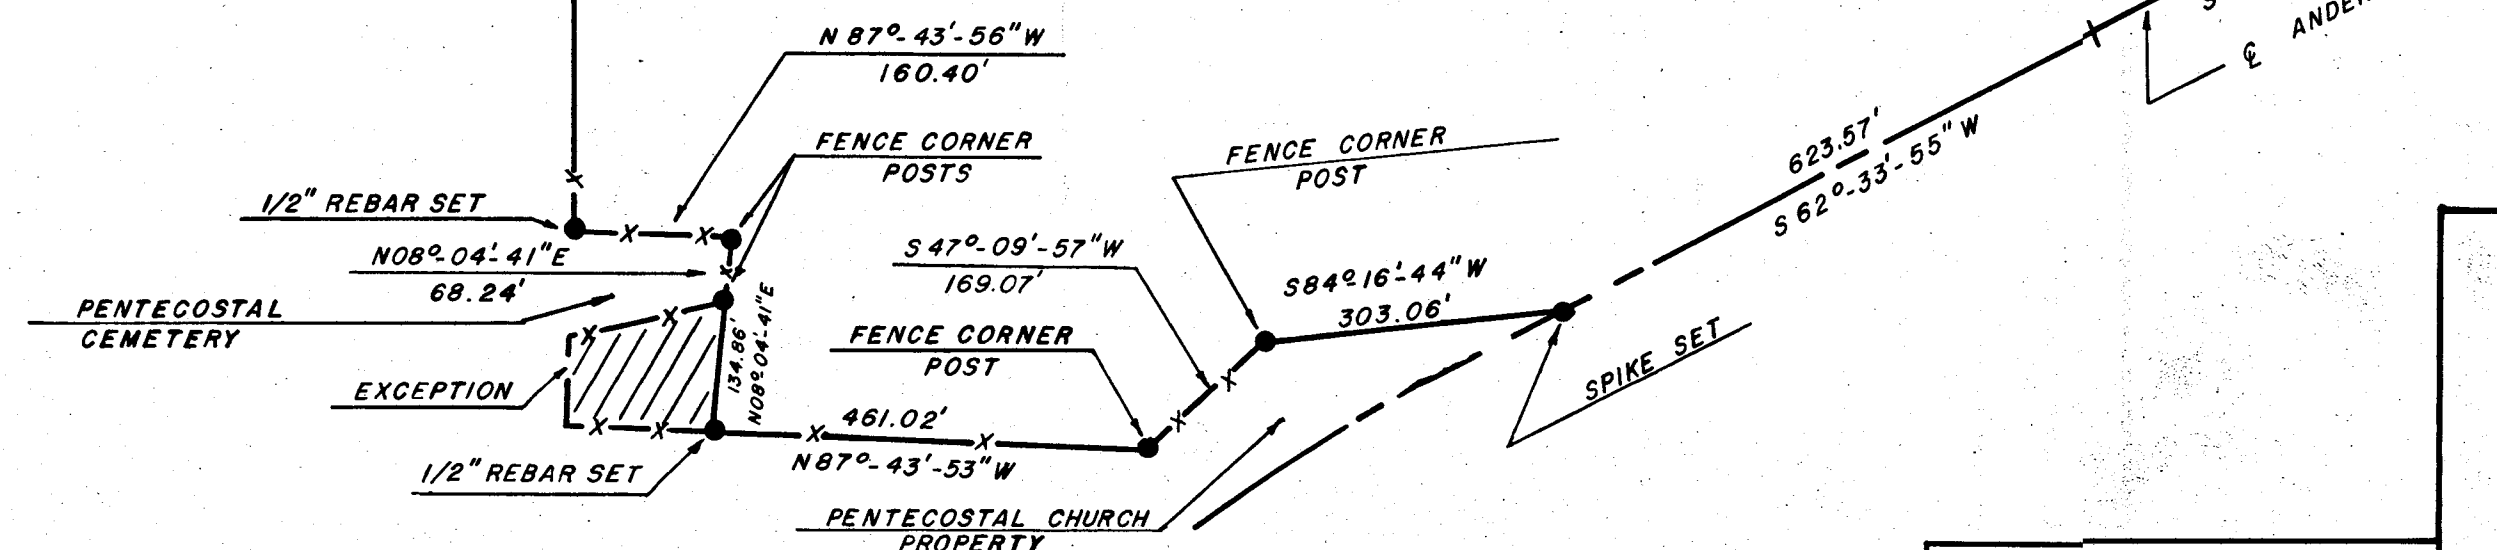

MONROE COUNTY SURVEYOR
 EDMUND O. FARKAS
 COUNTY HEALTH BLDG.
 ROOM 12
 BLOOMINGTON, IN. 47401
 PHONE: 812-333-3570

WASH U-17
Sec 25 NW
T.O.

WASH Y-15
Sec 24 E4
T.O.

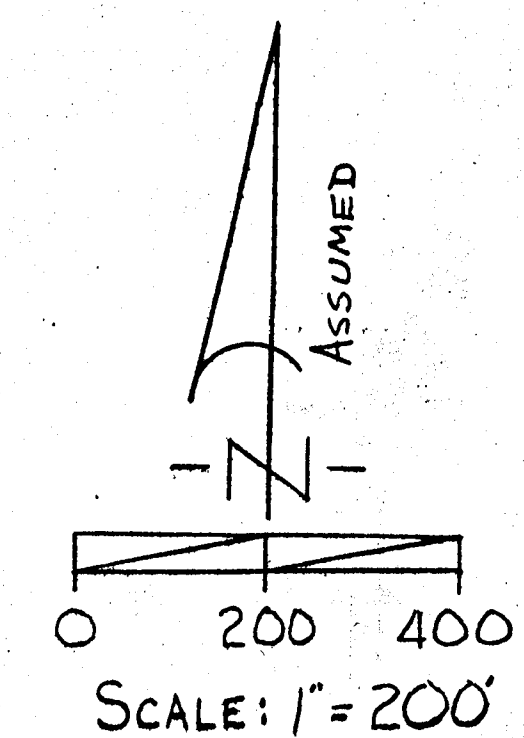



- STONE FOUND
- IRON ROD, PIPE, REBAR W/CAP FOUND
- ▲ SPIKE FOUND
- P.K. NAIL FOUND
- TREE ENGRAVED "24, 25, RIW" THIS PROJECT
- SPIKE SET
- △ P.K. NAIL SET
- △ NO MONUMENT SET OR FOUND
- 5/8 INCH DIAMETER REBAR W/ CAP MARKED "CURRY 890006" SET

MCSWMD - MONROE COUNTY SOLID WASTE MANAGEMENT DISTRICT

Job No. 041898
Owner: Alvin C. Johnson & Marcella A. Johnson
Source: D.R. 452, P. 658
A part of Section 25, Township 10 North, Range 1 West, Washington Township, Monroe County, Indiana

SUBJECT TO ALL EASEMENTS AND RIGHTS-OF-WAY.
Evidence of easements has not been located in the field and is not shown on the survey drawing.
This certification does not take into consideration additional facts that an accurate and correct title search and/or examination might disclose.
Subject to the above reservations, I hereby certify that the work performed on the project shown hereon was performed by me or under my direct supervision and control, and that all information shown is true and correct to the best of my knowledge and belief.

Certified this 30th day of June, 1998
Douglas R. Curry
Douglas R. Curry (Indiana L.S. No. 890006)
621 N. College Ave.
Bloomington, IN 47404
812-332-9037

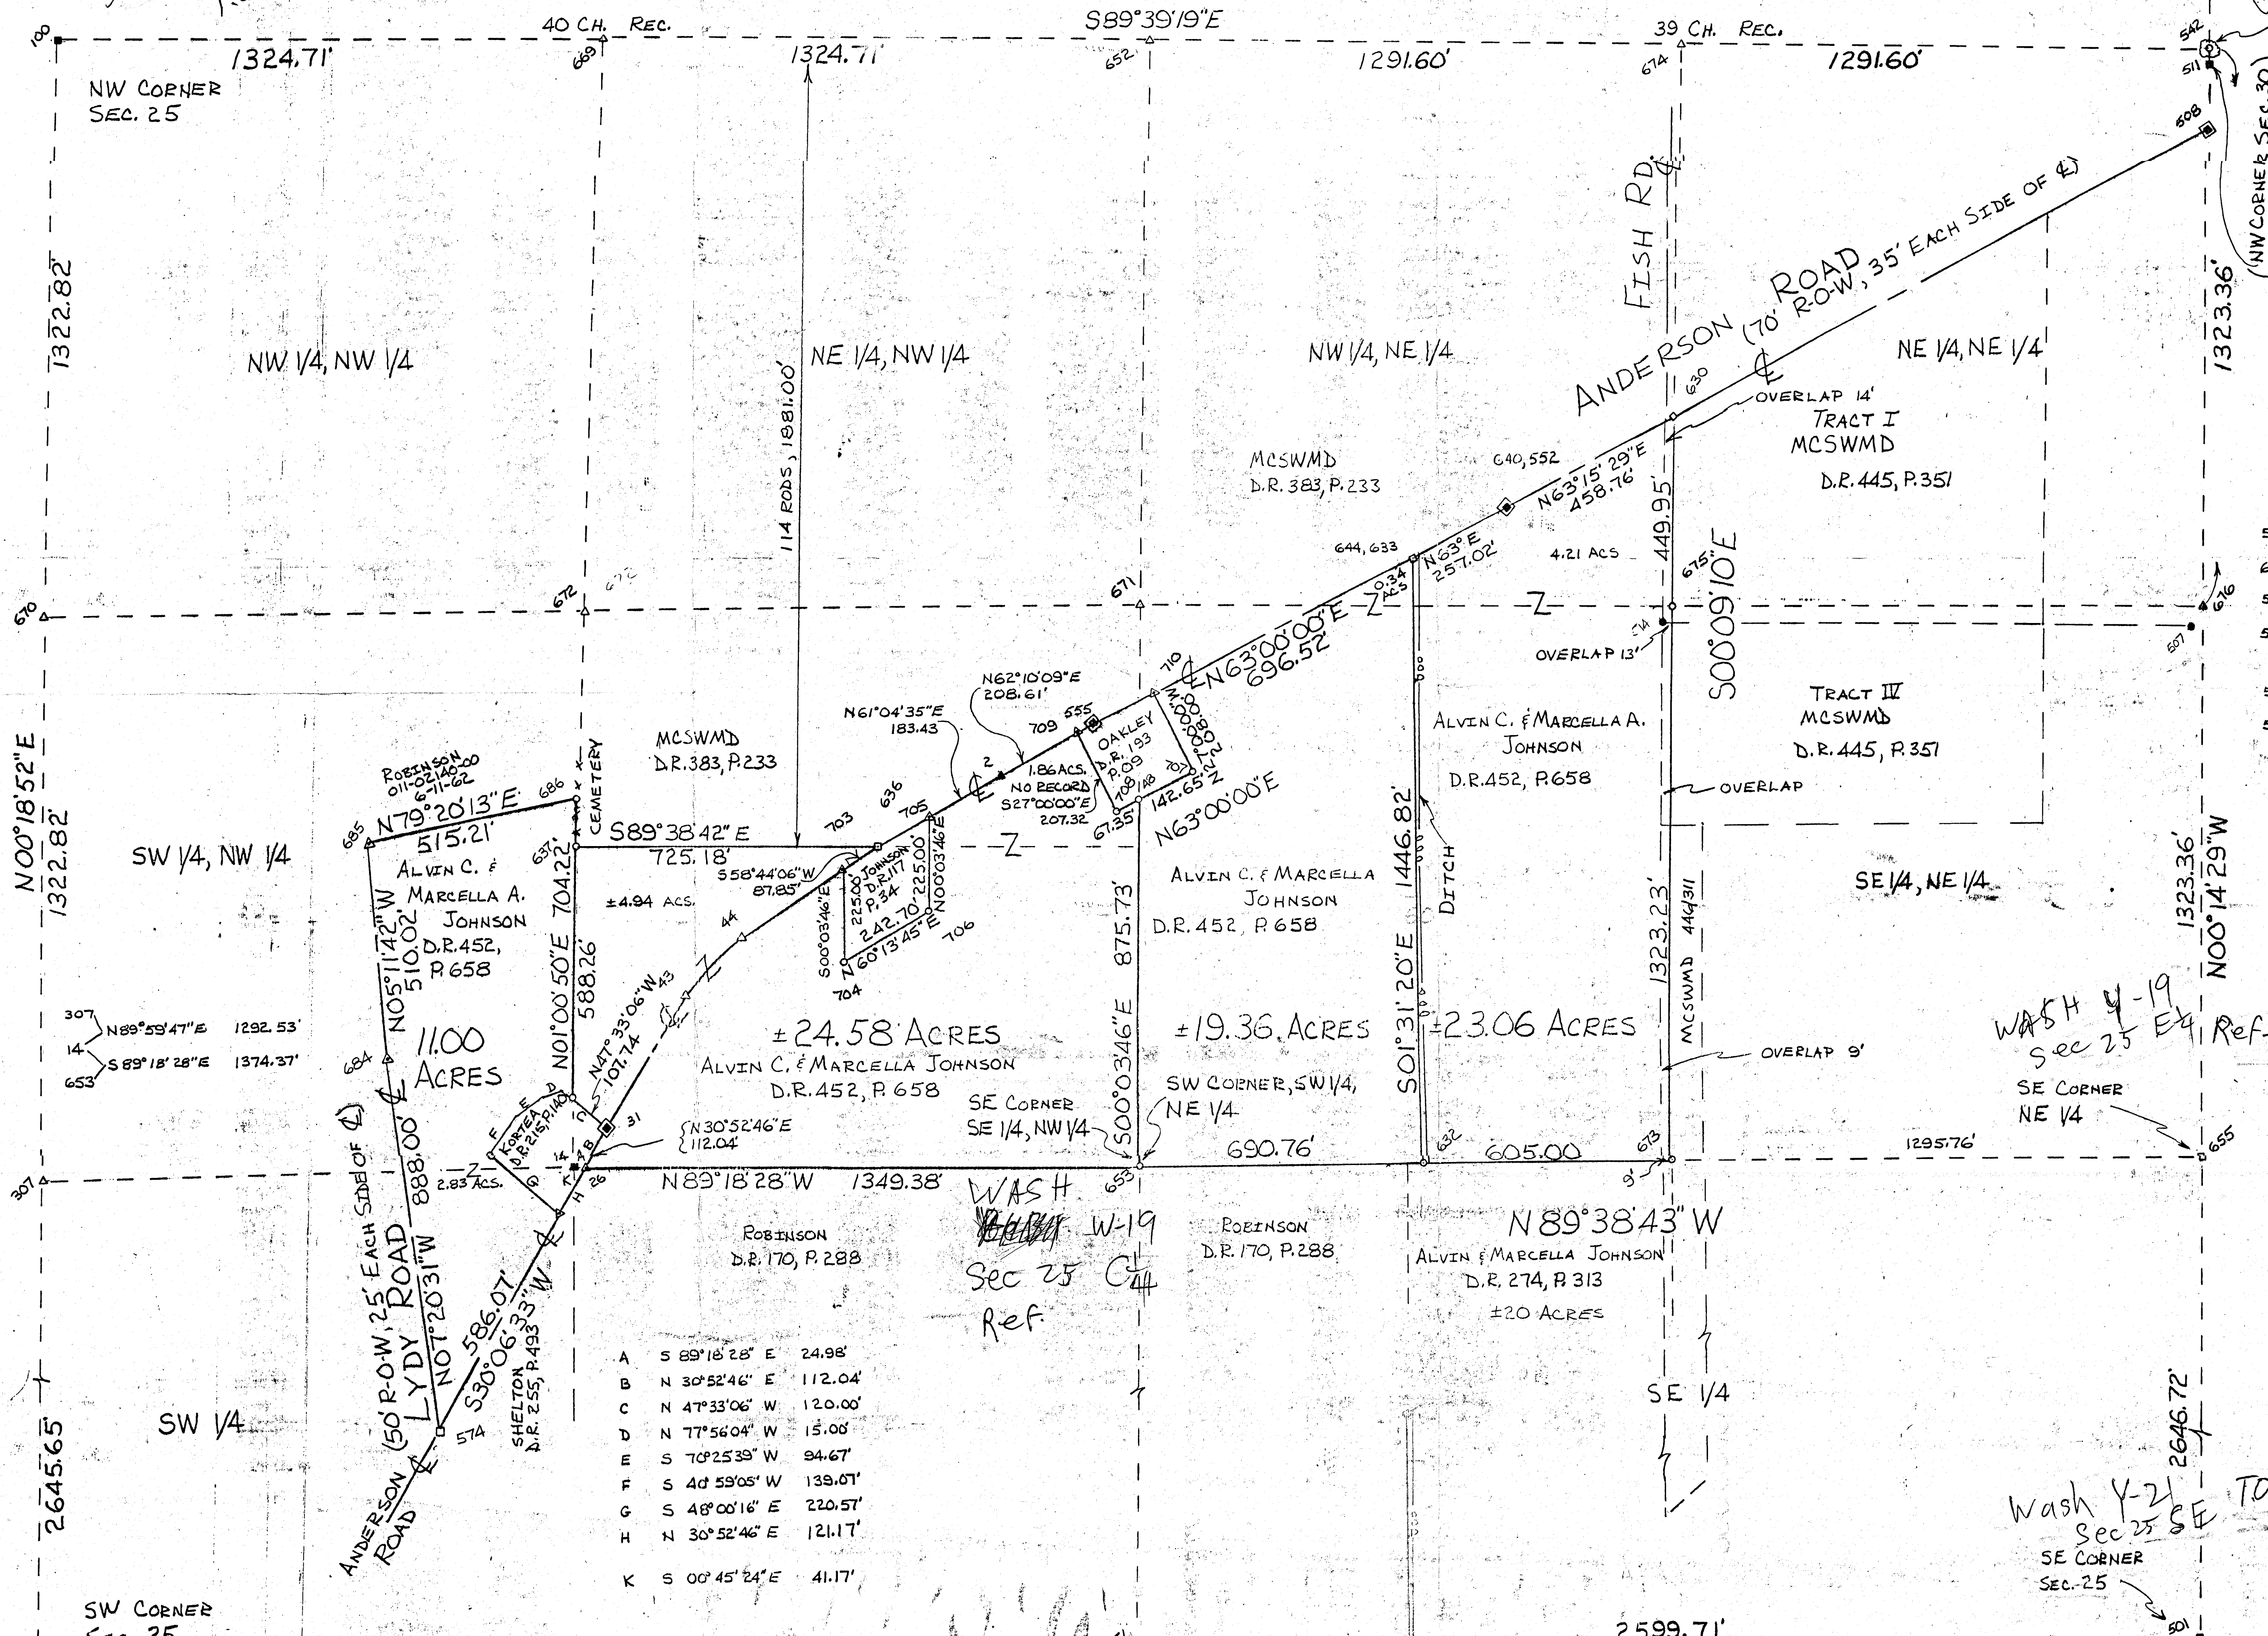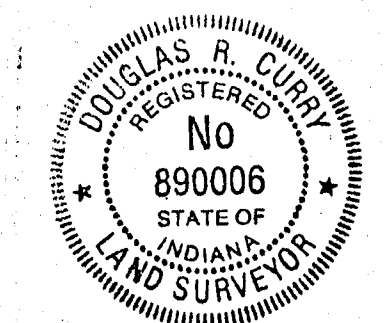


A	S 89°18'28" E	24.98'
B	N 30°52'46" E	112.04'
C	N 47°33'06" W	120.00'
D	N 77°56'04" W	15.00'
E	S 70°25'39" W	94.67'
F	S 40°59'05" W	139.07'
G	S 48°00'16" E	220.57'
H	N 30°52'46" E	121.17'
K	S 00°45'24" E	41.17'

WASH W-19
Sec 25 C4
Ref.

WASH Y-19
Sec 25 E4
Ref.

WASH Y-21
Sec 25 SE
T.O.

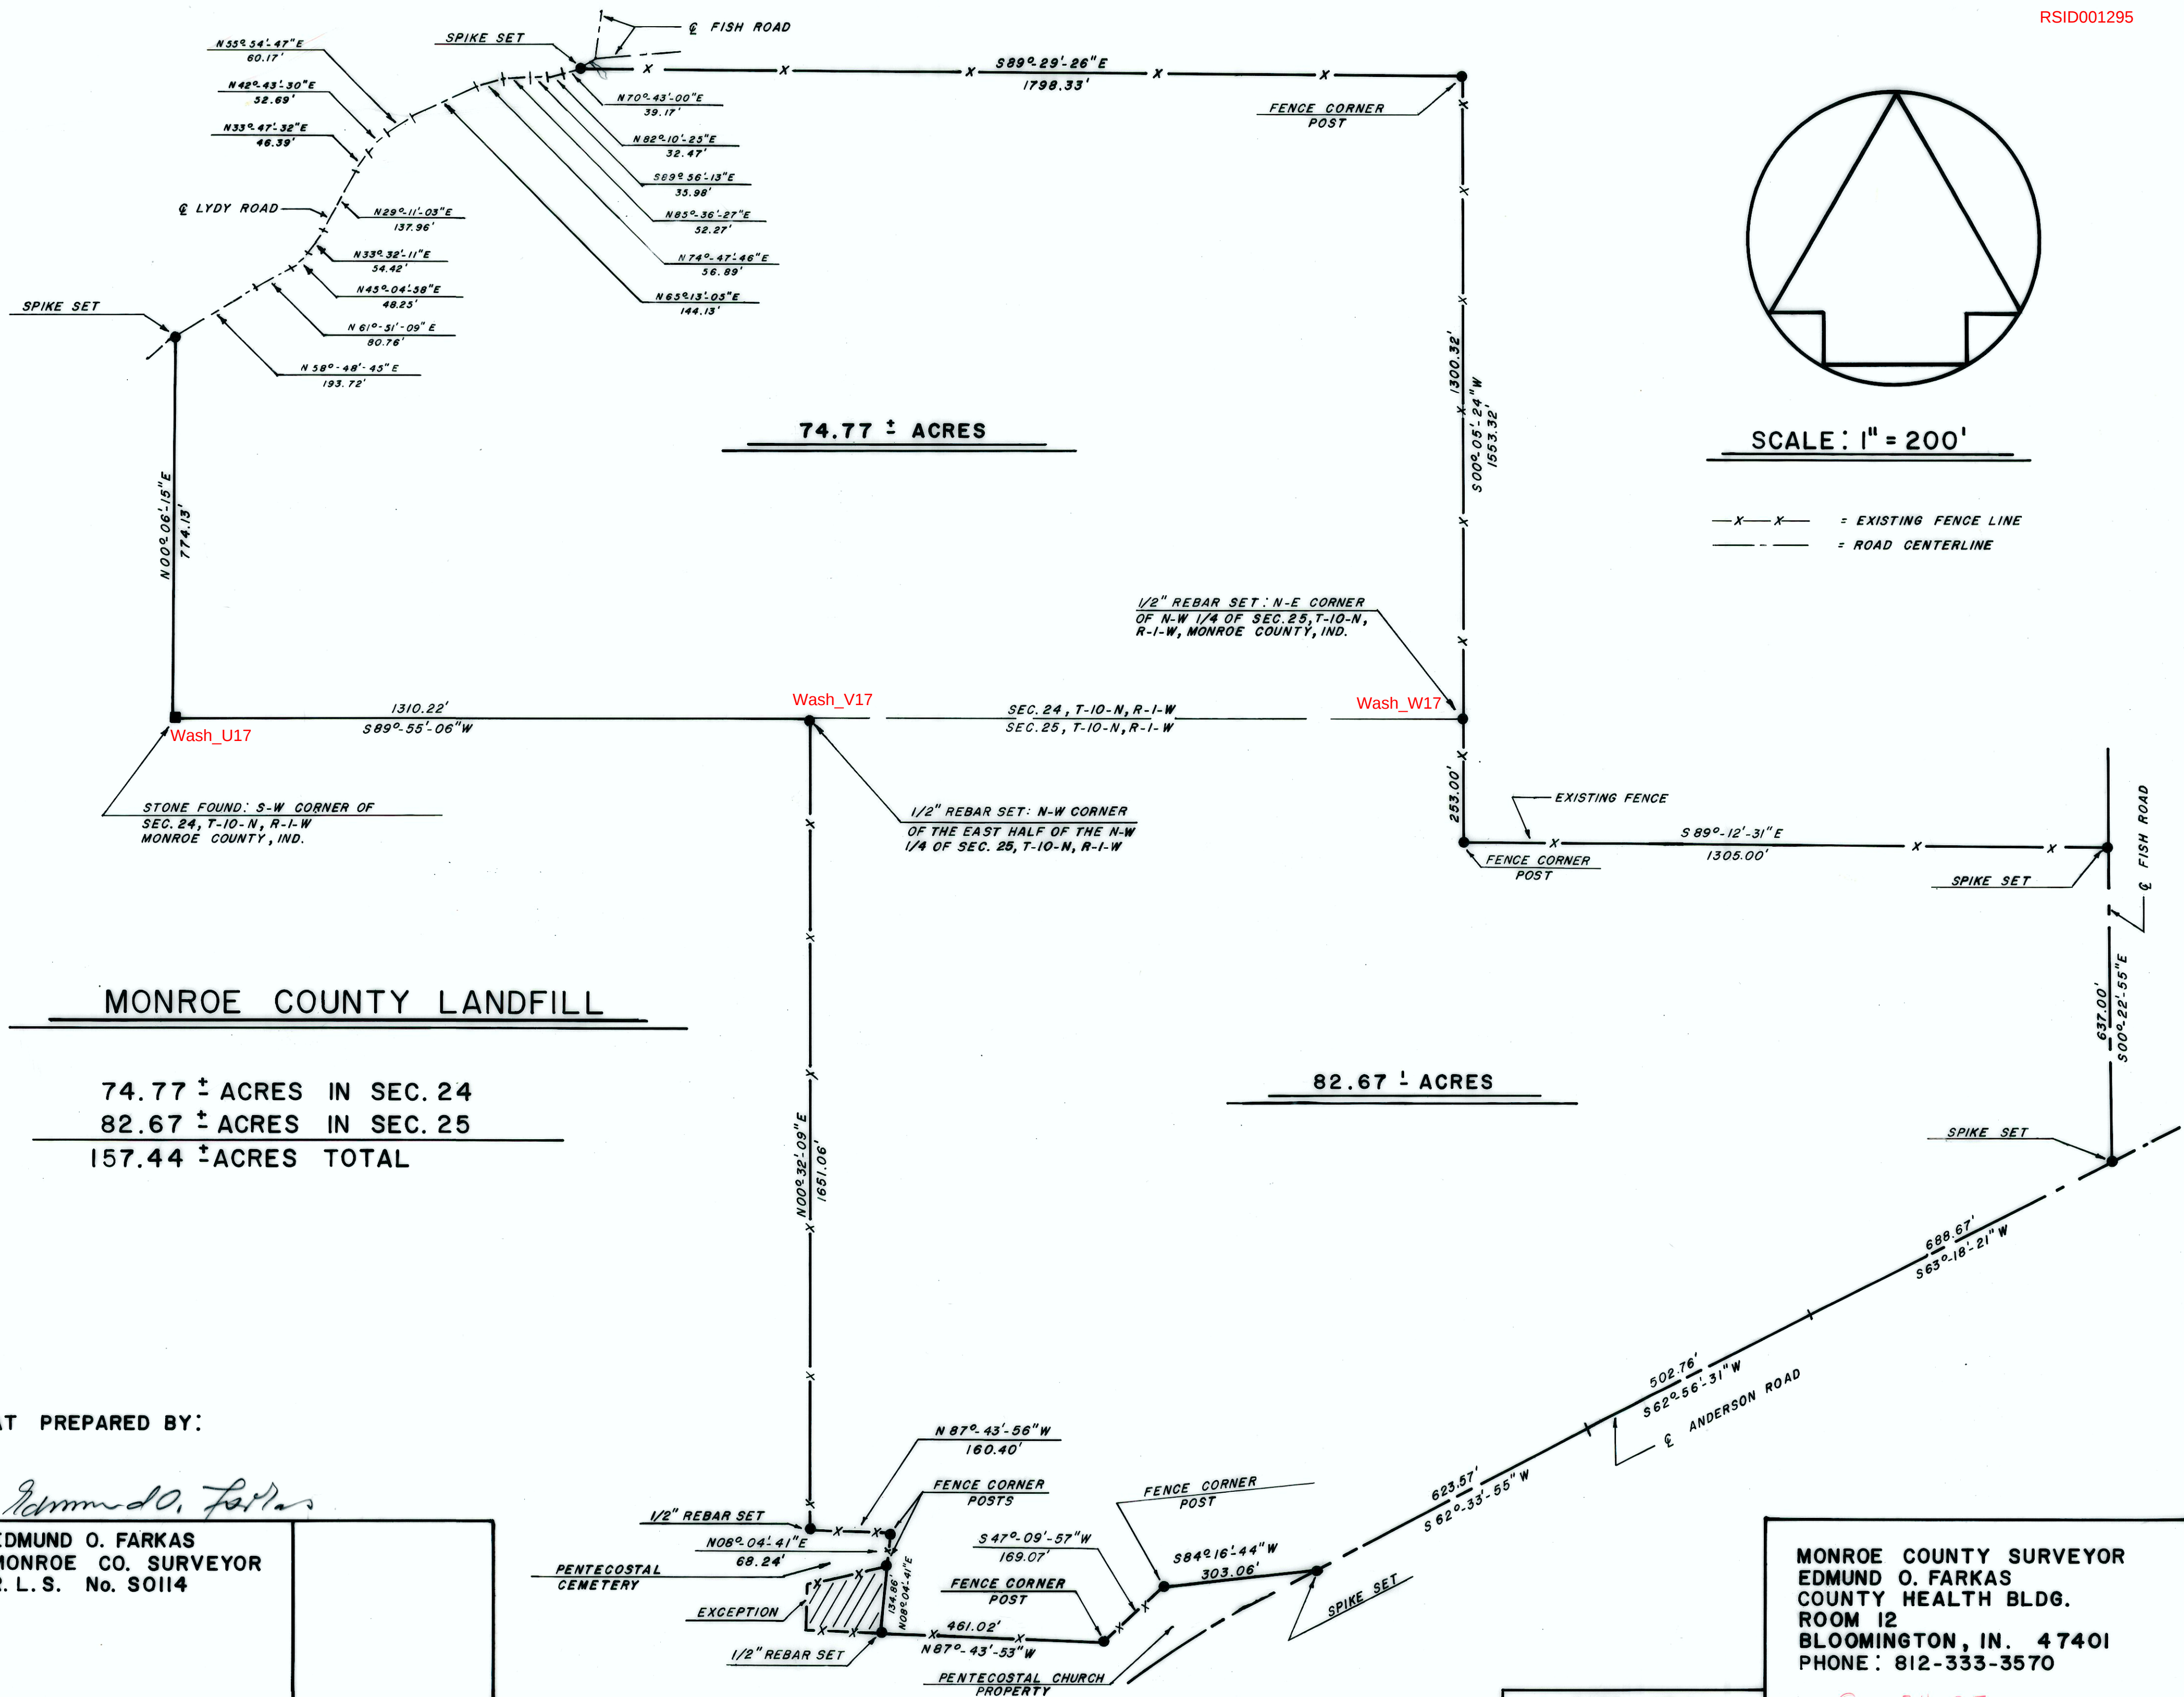

To the N W corner of said section Then commenced at the northern $\frac{1}{2}$ mile post and ran $3\frac{1}{2}^{\circ}$ E 324 Poles & 8 lks to the southern $\frac{1}{2}$ mile post of said section (1) Corner established corner and made witness cut the S W corner of $\frac{1}{4}$ of South east quarter of section No 9 Black Ash 7 inches in diameter N 18° E $28\frac{1}{2}$ links distant witness trees made on said north and south line where it crosses the boundary line Beech 18 inches in diameter S 64° E 34 links distant Then began at the center of said section (1) ran N 85° E 160 Poles to the meridian line

Benjamin Polley & chain bearers
Alexander Jackson } sworn

James W Spencer
Monroe County Surveyor

February 7th A D 1854

Ran the following lines and made the following corners in section No 30 of 10 R 1 E of second principal meridian Beginning at S W corner of said section Thence N 85° E 157 Poles to the S E corner of the same Witness trees made at the $\frac{1}{2}$ mile post of said section No 30 Hickory 2 inches in diameter N $42\frac{1}{2}^{\circ}$ E $2\frac{1}{2}$ links distant Black Ash 3 inches in diameter S $33\frac{1}{2}^{\circ}$ W 9 $\frac{1}{2}$ links distant Thence N 6° W 162 poles and 8 links to a stone standing in open ground and consequently no witness trees made Thence S 85° W 79 Poles and $1\frac{1}{4}$ links to the western $\frac{1}{2}$ mile post of said section 30 witness trees made Sycamore 6 inches in diameter N 80° E $8\frac{1}{2}$ links distant Sycamore 4 inches in diameter N $39\frac{1}{2}^{\circ}$ W 7 lks distant — Witness made 81 Poles and 4 links north of the southern $\frac{1}{2}$ mile post of said section No 30 of 10 R 1 E Sugar 10 inches in diameter S 37° W 12 links distant Sugar 15 inches in diameter N 12° E $24\frac{1}{2}$ links distant

John Brantburn & chain bearers
Benjamin Polley } by consent of parties

James W Spencer
Monroe County Surveyor

The above survey was done for Edward Jackson and Benjamin Polley

February 8th A D 1854

Ran the following lines and made the following corners in section No 25 of 10 R 1 W for Edward Jackson and John Martin — Length of line from Eastern half mile post of said section 25

Witness trees at Eastern half mile post Sycamore 6 inches in diameter $N 80^{\circ} E$ $8\frac{1}{2}$ links distant Sycamore 4 inches in diameter $N 39\frac{1}{2}^{\circ} W$ 7 links distant Thence 15.8 Poles to the center of said Section - Witness trees made 49 Poles East of center Maple 8 inches in diameter $N 61^{\circ} W$ 8 links distant

February 23 A D 1854

Ran the following lines and made the following corners in Section No 18 T 8 R 7 E for Henderson Ellis and William Harrison. Beginning at the northern $\frac{1}{2}$ mile post of said Section the ran $S 5\frac{1}{2}^{\circ} E$ 80 poles to a stone witness tree poplar 6 in diameter $N 32^{\circ} W$ 4 lks dist Dogwood 2 inches in diameter $S 1\frac{1}{2}^{\circ} E$ 16 lks dist then $N 83^{\circ} E$ 80 poles to a stone witness tree Birch 30 inches in diameter $S 57\frac{1}{2}^{\circ} E$ 15 $\frac{1}{2}$ lks distant, Dogwood 5 inches in diameter $N 6\frac{1}{2}^{\circ} E$ 32 $\frac{1}{2}$ lks distant

Chain bearers Calloway Mefford and John Bollinghouse by consent of parties

James W. Spencer
Monroe County Surveyor

February 23 A D 1854

Ran the following lines and made the following corners in Section No 7 T 8 R 1 E for Calloway & Mefford. Beginning at the center of said Section ran thence $S 5\frac{1}{2}^{\circ} E$ 80 poles to a stone witness tree Birch 20 inches in diameter $S 64\frac{1}{2}^{\circ} E$ 14 links distant Birch 10 inches in diameter $S 66^{\circ} W$ 20 $\frac{1}{2}$ links distant. Henderson Ellis and John Bollinghouse chain bearers by consent of parties

James W. Spencer
Monroe Co Surveyor



Feb 24th A D 1854

Ran the following lines lot of land as deliver for Mary Adams widow of Adams deceased late of Monroe County Indiana Situated in the South East quarter of Section No 27 Township No 8 North of Range No 1 West and bounded as follows to wit Beginning

April 8th 1852

Surveyed for 6 Tralls John Sullivan
 & John Martin in Section No 25 T10 R1 Tr 4 established
 the following corners Cor A is N E cor of 1/2 of A E gr
 witness Hickory 20 in diam S 24° E 42 lbs dist oak 30 in
 diam N 68° E 22 lbs dist



Cor B S E cor of 1/2 of A E gr witness Buck 18 in
 diam N 77 1/2° E 26 links dist Buck 8 in diam N 33° E 33
 lbs dist


Cor C S E cor of 1/2 of A E gr of S E gr witness Buck 12 in
 diam N 45° E 23 lbs dist Buck 10 in diam N 72° E 42 lbs
 dist

Cor D center of the section witness Burr Oak 24 in dia
 S 23° E 41 lbs dist Hickory 8 in diam S 72° E 22 links distant
 Noah Payne & Jo Payne chain bearers
 Countrod Malls & John Sullivan Sworn

James Goodborn No 6 S

April 17 & 18

Surveyed for Samuel Latimore & others
 in Section 36 T9 R1 met & established the following
 corners Cor A the N E cor of South half of S E gr
 witness Blue Ash 24 in diam N 12° E 25 1/2 lbs dist Buck

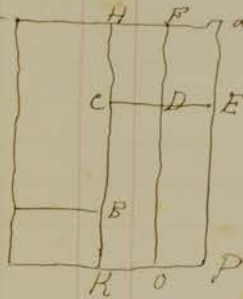

20 in diam S 40° E 39 lbs dist

Cor B N E cor of 1/2 of S E gr witness 13 Walnut 16
 in diam N 75° E 36 lbs dist Buck 20 in diam S 35° E
 76 lbs dist

Cor C S E cor of 1/2 of A E gr
 witness 7 in diam S 22 1/2° E 10 lbs dist
 Poplar 8 in diam N 14° E 33 lbs dist

Cor D A E cor of S E gr of A E gr witness 16
 Elm 16 in diam N 81° E 5 lbs dist Elm 7 in diam

N 12° E 3 1/2 lbs dist Cor E S E cor of A E gr of A E gr
 witness 14 in diam west 52 lbs dist Buck 10 in dia

Cor F N E cor of A E gr of A E gr witness 7 in diam N 19° E 18 1/2 lbs dist

North 1/2 mile witness Sycamore 6 in diam S 34° E 55 lbs dist
 Buck 18 in diam S 51 1/2° E 181 lbs dist

length from a to b 3 22/100 poles over mile b to c 10 feet under mile
 North half mile 32 ft over H H 18 ft under a m 9 over 1/2
 mile

James Allen & John Rock
 Chain Bearers Sworn

James Goodborn No 6 S

March 19th 1852

Sec 18 T 8 R 1 W



Surveyed in Section 18 T 8 R 1 W
for Thomas Bartter and others
Established the following corners
corner C center of Section 18 in
indiameter S 27° E 20 lks Sugar 12 in
indiameter S 5° W 54 lks

corner D center on north end of S W gr
White Oak 24 S 62° E 48 lks
Hickory 30 S 18° W 60

Corner B middle of line on west side
(variation 5°)

Line C. B.	171	$\frac{72}{100}$	White oak 20 S 2° W 20 lks distant
" H. K.	172	$\frac{76}{100}$	White oak 18 S 32° E 82 "
" D. E.	161		(another line measured)
A. K.	322	$\frac{97}{100}$	

Corner E Walnut 42 N 45° W 44 lks Sugar 14 N 40° E 65

" H The original witness tree standing Stone planted

" A N W corner of Section 18 oak S 32° W 32 poplar 16 N 30° E 57 lks

" L N ½ m p Sugar 15 S 1° W 35 lks

Stone set at all the corners

Edward Borland / Chain bearers

James Borland / Sworn

James Woodburn
M. C. S.

Sec 25 T 10 R 1 W



April 8 1852

Surveyed for C Matlock
John Sullivan & John Martin
in Section 25 T 10 R 1 W and
established the following corners
corner A N E corner of west half N W gr
wit tree Hickory 20 S 24° E 42 lks

W oak 30 N 68° E 22 lks distant

Cor B S E corner west half of the N W gr

wit tree Buck 18 N 77° E 26 lks

Buck 5 N 33° E 33 lks

Cor O S E cor N W ¼ of S W gr of Section

Wit tree Buck 12 N 45° E 23 lks Buck 10 N 72° W 42 lks

Cor C center of Section Wit tree Bur oak 24 S 23° E 41 lks

Hickory 5 S 72° W 22 lks

W oak Payne & Jno Payne

Robert Walls & John Sullivan

Chain bearers

Sworn

James Woodburn
M. C. S.

Nov the 21st 1862

Ran the following line & made the following corner in Section 25 Town 10 Rang 1 West for John Martin & William A Anderson commenced at the Eastern 1/2 Mile Stake of Witnesses gone new one made equa distant between the Section corner Buck 19 inches N⁶⁸°W 6 links dist Buck 12 inches in diameter S⁶⁷°E 25 1/2 links dist thence S⁸⁵°W 79 poles 15 links Witness Water Oak 30 inches in diameter S⁸²°W 3 1/4 links dist Water Oak 25 inches in diameter N⁷⁷°E 68 links dist thence S⁶°E 159 poles + 13 links to corner Made before Chas Barers Jackson Huntz & Jasper A Gore sworn fees \$3.50 Martin \$1.50 paid Anderson \$2.25 paid

J S Buskirk M. C. S

December the 16th 1862

Ran the following line & made the following corner in Section 27 T 9 R 1 W for Lankston Brunet & Mathew Robertson commenced at the South East corner Old witness gone new one made Buck 20 inches in Diam S³²°W 17 links dist Sugar 18 inches in Diam S⁷²°E 29 lks dist thence N⁵°W 157 poles + 20 links to the Eastern 1/2 Mile Stake stone planted before Chas Barers Lankston Brunet & Mathew Robertson by consent fees \$1.50 L Brunet \$75 paid M Robinson \$75 paid

J. S. Buskirk M. C. S

December the 23rd 1862

Ran the following lines and made the following corners in Section 20 Township 9 Rang 1 East for John W Galyan and Anna Mefford commenced at the North West corner Ran N⁸⁶°E 80 poles corner made & stone planted Witness Lignum 35 inches in diam S⁵⁸°E 10 1/2 links Buck 20 inches in diam N⁶⁸°W 33 links dist thence S⁵°E 238 poles + 23 links corner made & stone planted Witness Buck 15 inches in diam N⁴⁵°E 14 links Dogwood 3 inches in diam S³²°E 17 1/2 links dist Chas Barers Anna Mefford & George W Galyan by consent fees \$3.00 J W Galyan \$1.50 paid Anna Mefford \$1.50 paid

J S Buskirk M. C. S

corner made 77 poles & 3 links South of the Southern half mile post & stone plandit.

corner made at the center of Section 31 T8 R1 E by planting a stone. corner made by planting a stone

corner made by planting a stone East of the center

corner made by planting a stone 80 poles $7\frac{1}{4}$ links east of the Southern $\frac{1}{2}$ mile post

length of the line South of the center 159 poles 23 links.

length of the line North of the center 160 poles 21 links

Columan Carter and William Shields.

Chain Bearers: sworn

James W. Spencer

Monroe County Surveyor.

November 30th A.D. 1863.

ran the following lot of land for Charles Coor Mary Clarkston & James Sullivan beginning at the North East corner of Section No 25 T10 R1 W stone planted and witness three red oak 12 inches diameter S 67° E 26 links distant then South with the Meridian 77 poles & 9 links ~~intercept~~ it being the intermediate distance between the North East corner of said Section No 25 to the Eastern $\frac{1}{2}$ mile of the same witness three Hickory 3. in diam N 48° E 40 links dist. then west 78 poles $1\frac{1}{2}$ links to a stake then North 77 poles & 9 links to a stake it being the intermediate distance between the North East corner of said Section No 25 to the Northern $\frac{1}{2}$ mile post of the same then East with the section line 78 poles $1\frac{1}{2}$ links to the beginning.


Chain bearers. Stephen Wilson & Hiram A. Baston
Sworn

James W. Spencer

Monroe County Surveyor.

April 8th 1852

Surveyed for to Wells John Sullivan
 & John Martin in Section No 25 T10 R1 Tr 4 established
 the following corners Cor A is N E cor of $\frac{1}{2}$ of A E sec
 witness Hickory 20 in diam S 24° E 42 lbs dist oak 30 in
 diam N 68° E 22 lbs dist

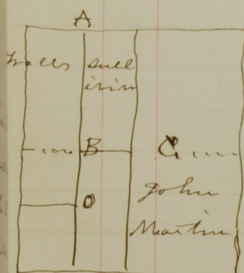

Cor B S E cor of $\frac{1}{2}$ of A E sec witness Buck 18 in
 diam N $77\frac{1}{2}^{\circ}$ E 26 links dist Buck 8 in diam N 33° E 33
 lbs dist


Cor C S E cor of A E sec of S E sec witness Buck 12 in
 diam N 45° E 23 lbs dist Buck 10 in diam N 72° E 42 lbs
 dist

Cor D Center of the Section witness Burr Oak 24 in dia
 S 23° E 41 lbs dist Hickory 8 in diam S 72° E 22 links distant
 Noah Payne & Jo Payne chain bearers
 Counted Wells & John Sullivan Sworn

James Woodburn N. C. S.

April 17. & 18

Surveyed for Samuel Latimore & others
 in Section 36 T9 R1. met & established the following
 corners Cor A the N E cor of South half of S E sec
 witness Blue Ash 24 in diam N 12° E $25\frac{1}{2}$ lbs dist Buck
 20 in diam S 40° E 39 lbs dist

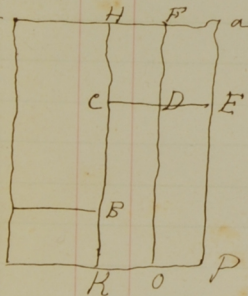

Cor B N E cor of S E sec of S E sec witness 13 Walnut 16
 in diam N 75° E 36 lbs dist Buck 20 in diam S 35° E
 76 lbs dist

Cor C S E cor of A E sec of A E sec witness 7 in diam S $22\frac{1}{2}^{\circ}$ E 10 lbs dist
 Poplar 8 in diam N 14° E 33 lbs dist

Cor D N E cor of S E sec of A E sec witness 7 in diam
 Elm 16 in diam N 81° E 5 lbs dist Elm 7 in diam
 N 12° E $3\frac{1}{2}$ lbs dist

Cor E S E cor of A E sec of A E sec witness 14 in diam West 52 lbs dist Buck 10 in dia
 wit Elm Buck 14 in diam West 52 lbs dist

Cor F N E cor of A E sec of A E sec witness 7 in diam N 19° E $18\frac{1}{2}$ lbs dist
 North $\frac{1}{2}$ mile wit Elm Sycamore 6 in diam S 34° E 55 lbs dist


length from a to b $3\frac{72}{100}$ poles over mile b to c 10 feet under mile
 North half mile 32 ft over H H 18 ft under a m 9 over $\frac{1}{2}$
 mile

James Allen & John Rock
 Chain Bearers Sworn

James Woodburn N. C. S.

March 19th 1852

Sec 18 T 8 R 1 W

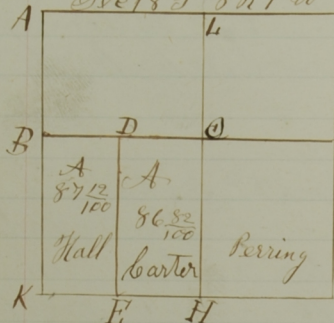

Vari 5°

Surveyed in Section 18 T 8 R 1 W
for Thomas Carter and others
Established the following corners
corner O center of Section Beech 18 in
indiameter S 29° E 20 lks Sugar 12 in
indiameter S 5° W 54 lks

corner D center on north end of S W gr
White Oak 24 S 22° E 49 lks
Hickory 30 S 18° W 60

corner B middle of line on west side
(variation 5°)

Line O. B.	171	$\frac{72}{100}$	White oak 20	S 2° W	20 lks. distant
" H. K.	172	$\frac{72}{100}$	White oak 18	S 32° E	82 "
" D. E.	161		(another line measured)		
A. K.	322	$\frac{97}{100}$			

corner E Walnut 42 N 45° W 44 lks Sugar 14 N 40° E 65

" H The original witness tree standing Stone planted

" A N W corner of Section 18 oak 8 S 2° W 32 poplar 16 N 30° E 37 lks

" L N ½ m p Sugar 18 S 10° W 35 lks


Stone Set at all the corners

Edward Borland / chain bearers

James Borland / Sworn

James Woodburn
M. C. S.

Sec 25 T 10 R 1 W

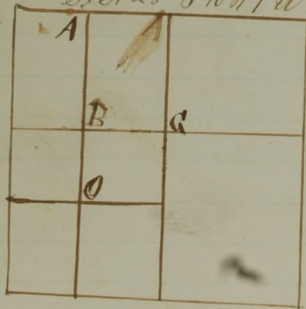

April 8 1852

Surveyed for C Matlock
John Sullivan & John Martin
in Section 25 T 10 R 1 W and
established the following corners
corner A N E corner of west half N W gr
wit tree Hickory 20 S 24° E 42 links

W oak 30 N 68° E 22 lks distant

Cor B S E corner west half of the N W gr

wit tree Beech 18 N 77° E 26 links

Beech 5 N 33° E 33 lks

Cor O S E cor N W ¼ of S W gr of Section

Wit tree Beech 12 N 43° E 23 lks Beech 10 N 72° W 42 lks

Cor C center of Section Wit tree Bur oak 24 S 23° E 41 lks

Hickory 5 S 72° W 22 lks

Noak Payne & Jno Payne }
Coarrod Walls & John Sullivan }

Chain bearers
Sworn

James Woodburn
M. C. S.

To the N W corner of said Section Then commenced at the Northern $\frac{1}{2}$ mile post and ran $5\frac{1}{2}^{\circ}$ E 324 Poles & 8 lks To the Southern $\frac{1}{2}$ mile post of said Section (1) Corner established corner and made witness cut the S W corner of $\frac{1}{4}$ of South east quarter of section No 9 Black Ash 7 inches in diameter N 18° E $28\frac{1}{2}$ links distant witness trees made on said north and south line where it crosses the boundary line Beech 18 inches in diameter S 64° E 34 links distant Then began at the center of said Section (1) ran N 85° E 160 Poles to the meridian line

Benjamin Polley & chain bearers
Alexander Jackson } sworn

James W Spencer
Monroe County Surveyor

February 7th A D 1854

Ran the following lines and made the following corners in section No 30 of 10 R 1 E of second principal meridian Beginning at S W corner of said Section Thence N 85° E 157 Poles to the S E corner of the same Witness trees made at the $\frac{1}{2}$ mile post of said Section No 30 Hickory 2 inches in diameter N $42\frac{1}{2}^{\circ}$ E $2\frac{1}{2}$ links distant Black Ash 3 inches in diameter S $33\frac{1}{2}^{\circ}$ W $9\frac{1}{2}$ links distant Thence N 6° W 162 poles and 8 links to a stone standing in open ground and consequently no witness trees made Thence S 85° W 79 Poles and $14\frac{1}{2}$ links to the western $\frac{1}{2}$ mile post of said Section 30 witness trees made Sycamore 6 inches in diameter N 80° E $8\frac{1}{2}$ links distant Sycamore 4 inches in diameter N $39\frac{1}{2}^{\circ}$ W 7 lks distant — Witness made 81 Poles and 4 links north of the Southern $\frac{1}{2}$ mile post of said Section No 30 of 10 R 1 E Sugar 10 inches in diameter S 37° W 12 links distant Sugar 15 inches in diameter N 12° E $24\frac{1}{2}$ links distant

John Brantburn & chain bearers
Benjamin Polley } by consent of parties

James W Spencer
Monroe County Surveyor

The above survey was done for Edward Jackson and Benjamin Polley

February 8th A D 1854

Ran the following lines and made the following corners in Section N 25 of 10 R 1 W for Edward Jackson and John Martin — Length of line from Eastern half mile post of said Section 25

Witness trees at Eastern half mile post Sycamore 6 inches in diameter $N 80^{\circ} E$ $8\frac{1}{2}$ links distant Sycamore 4 inches in diameter $N 39\frac{1}{2}^{\circ} W$ 7 links distant Thence 15.8 Poles to the center of said Section - Witness trees made 49 Poles East of center Maple 8 inches in diameter $N 61^{\circ} W$ 8 links distant

February 23 A D 1854

Ran the following lines and made the following corners in Section No 18 T 8 R 7 E for Henderson Ellis and William Garrison, Beginning at the northern $\frac{1}{2}$ mile post of said Section the ran $S 5\frac{1}{2}^{\circ} E$ 80 poles to a stone witness trees poplar 6 in diameter $N 32^{\circ} W$ 4 lks dist Dogwood 2 inches in diameter $S 2^{\circ} E$ 16 lks dist, then $N 83^{\circ} E$ 80 poles to a stone witness trees Beech 30 inches in diameter $S 67\frac{1}{2}^{\circ} E$ $15\frac{1}{2}$ lks distant, Dogwood 5 inches in diameter $N 6\frac{1}{2}^{\circ} E$ $32\frac{1}{2}$ lks distant


Chain bearers Calloway Mufford and John Bottinghouse by consent of parties

James W Spencer
Monroe County Surveyor

February 23 A D 1854

Ran the following lines and made the following corners in Section 17 T 8 R 1 E for Calloway & Mufford, Beginning at the center of said Section ran thence $S 5\frac{1}{2}^{\circ} E$ 80 poles to a stone witness trees Beech 20 inches in diameter $S 64\frac{1}{2}^{\circ} E$ 14 links distant Beech 10 inches in diameter $S 66^{\circ} W$ 20 $\frac{1}{2}$ links distant. Henderson Ellis and John Bottinghouse chain bearers by consent of parties

James W Spencer
Monroe Co. Surveyor

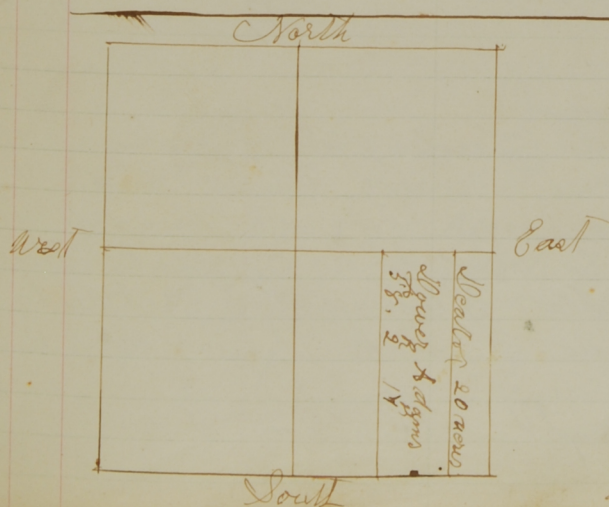

Feb 24th A D 1854

Ran the following lines lot of land as dower for Mary Adams widow of Adams deceased late of Monroe County Indiana Situated in the South East quarter of Section No 24 Township No 8 north of Range No 4 West and bounded as follows to wit Beginning

Nov the 21st 1862

Ran the following lines & made the following corners in Section 25 Town 10 Rang 1 West for John Martin & William N Anderson commenced at the Eastern $\frac{1}{2}$ Mile Stake of Witnesses gone new ones made equa distant between the Section corners Buck 18 inches N⁶°W 6 links dist Buck 12 inches in diameter S⁶¹°E 25 $\frac{1}{2}$ links dist thence S 85 $\frac{1}{2}$ °W 79 poles 15 links Witness Water Oak 30 inches in diameter S 21 $\frac{1}{2}$ °W 31 $\frac{3}{4}$ links dist Water Oak 25 inches in diameter N 79°E 68 links dist thence S⁵°E 159 poles & 13 links to corner made before Chas Barers Jackson Huntz & Jasper N bore sworn fees \$3.50 Martin \$1.50 paid Anderson \$2.25 paid

J S Buskirk M. C. S

December the 16th 1862

Ran the following line & made the following corner in Section 27 T⁹ R 1 W for Lankston Brunet & Matthew Robertson commenced at the South East corner Old witness gone new one made Buck 20 inches in Diam S 32°W 17 links dist Sugar 18 inches in Diam S 72°E 29 lps dist thence N 5°W 157 poles & 20 links to the Eastern $\frac{1}{2}$ Mile Stake stone planted before Chas Barers Lankston Brunet & Matthew Robertson by consent fees \$1.50 L Brunet \$75 paid M Robertson \$75 paid

J. S. Buskirk M. C. S

December the 23rd 1862

Ran the following lines and made the following corners in Section 20 Township 9 Rang 1 East for John W Galyan and Anna Mefford commenced at the North West corner Ran N 86°E 80 poles corner made & stone planted Witness Lignum 35 inches in diam S 58°E 10 $\frac{1}{2}$ links Buck 20 inches in diam N 68°W 33 links dist thence S⁵°E 238 poles & 23 links corner made & stone planted Witness Buck 15 inches in diam N 41°E 14 links Dogwood 3 inches in diam S 32°E 17 $\frac{1}{2}$ links dist Chas Barers Anna Mefford & George W Galyan by consent fees \$3.00 J W Galyan \$1.50 paid Anna Mefford \$1.50 paid

J S Buskirk M. C. S

corner made 79. poles & 3 links South of the Southern half mile post & stone plandit.

corner made at the center of Section 31 T8 R1. E by planting a stone. corner made by planting a stone

corner made by planting a stone East of the center

corner made by planting a stone 80 poles $7\frac{1}{4}$ links east of the

X Southern $\frac{1}{2}$ mile post

length of the line South of the center 159. poles 23. links.

length of the line North of the center 160. poles 21. links

Coleman Carter and William Shields.

Chain Bearers: sworn

James W. Spencer

Monroe County Surveyor.

November 30th A.D. 1863.


ran the following lot of land for Charles Coor Mary Clarkston & James Sullivan beginning at the North East corner of Section No 25 T10 R1. W stone planted and witness three red oak 12 inches diameter S 67° E 26 links distand then South with the Meridian 79. poles & 9 links. ~~intercept~~ it being the intermediate distance between the North East corner of said Section No 25 to the Eastern $\frac{1}{2}$ mile of the same witness three Hickory 3. in dian N 48° E 40 links dist. then west 78 poles $1\frac{1}{2}$ links to a stake then North 79. poles & 9 links to a stake it being the intermediate distance between the North East corner of said Section No 25 to the Northern $\frac{1}{2}$ mile post of the same then East with the Section line 78 poles $1\frac{1}{2}$ links to the beginning.

Chain bearers. Stephen Wilson & Liram A. Bastow
sworn

James W. Spencer

Monroe County Surveyor


March the 15th 1893 Surveyed for John W. Hacker Jacob Bennet, John L. Polley and others in section 25 Town 10 North, Range one West. Began at the North West corner of the North East quarter of the North West quarter of section 25 run south one half mile to corner himestone established and connected same. Perpetuated corner at beginning place as shown by plat. By agreement the aforesaid John W. Hacker and Jacob Bennet were sworn as assistants Chain bearers and John L. Polley Flag Bearer

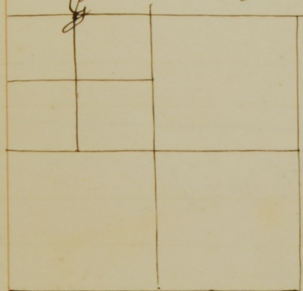

W oak 8 in N 88 $\frac{1}{2}$ E 31 $\frac{1}{2}$ links
Beech 18 in S 64 $\frac{1}{2}$ W 40 "

The foregoing is a true statement of the work by me done signed
This March the 29th 1893.
George B. Reader Dpty
M. C. S.

March the 27th 1893 Surveyed for James Galyean Wm Galyean and John Therr in section 29, Town 9 North Range one East and established corner as presented on plat. By agreement James Galyean and John Therr were sworn Chairman and Wm Galyean Flag bearer

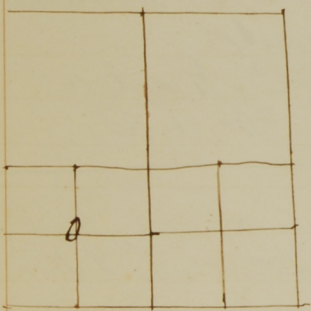

W oak 12 in N 88 $\frac{1}{2}$ W 24 lbs
W oak 1 $\frac{1}{2}$ in N 82 $\frac{1}{4}$ E 10 $\frac{1}{4}$ "
W oak 1 $\frac{1}{2}$ in S 80 $\frac{1}{2}$ W 22 $\frac{1}{2}$ lbs


April 1st 1893 Surveyed for the Kenwood land company Dr. Joe Rogers president and A. V. Harris Secretary and Minnie A. Hunter. represented by Morton C. Hunter. her father and by agreement established corner as follows in the center of the north tumpit known as Rights left S 1 $\frac{1}{2}$ W tree bearing from a point where said crosses the northern boundary of Section 33 T 9 N R one W 1578 feet distant witnessed by Sugar 24 in S 41 $\frac{1}{2}$ E 56 ft distant Sugar 25 in S 49 $\frac{1}{2}$ E 58 ft distant corner two feet long drove in the ground to the surface I was assisted by city engineer George B. Reader

George B. Reader

George B. Reader
Dpty M. C. S.

Patten & Warren Survey.

Nov. 11th 1895 - at request of W. H. Patten and Dr. Warren made a survey and established corner at an half dist between East half mile post and north East corner of section 3. Town 7 North Range one East as by plat and field notes below. I had for my assistants David P. Bartly and Henry S. Hager chain markers and J. L. Werring Flagman all duly sworn T. T. N. R. 1. C.

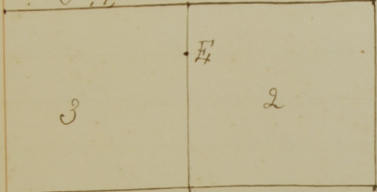


Half the dist. bet. $6\frac{1}{2}$ mi post & N.E. cor of sec. 3.
 E. C. line 12 in N. $44\frac{3}{4}$ E. 23 lks.
 Sweet Gum 4 in S. $47\frac{1}{2}$ East $7\frac{1}{3}$ lks.

The above is a true statement of the survey by me made and I verily believe George B. Rader Dpy M. C. Surveyor.

E. Edward Martin Survey.

June the 20th 1895 met pursuant to notice given by Edward Martin in writing and served on Taylor Martin Com^{rs} Anderson L. B. Moree and Dora Moree Guardian of Wm Moree at the house of George Payne said notice having been duly served at least ten days before hand and proceeded to run the section line between 25 & 36 Town Ten North Range one west and established corner at half distance between the North West Corner and North half mi post of sec. 36. and on the 17th of September 1895 all the above parties together with Jonathan Sutz met on the above section line at the corner at the half distance between the North East corner and the the north half mile post of sec. 36. and said corner was reestablished and said survey was completed as presented by Plat and field notes below.

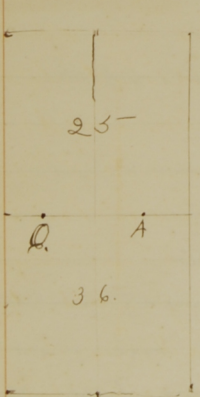

Beech 21 in West $13\frac{2}{3}$ lks. a C. S. recorded line tree
 W. Oak 2 in N. 47. W. $31\frac{1}{2}$ lks.
 Reestablished
 A { Burr Oak $7\frac{1}{2}$ in S. $47\frac{1}{2}$ W. $67\frac{2}{3}$ lks.
 W. Walnut $2\frac{1}{2}$ in S. 62 E $42\frac{2}{3}$ lks

I here by certify that the notice of the above survey is lost or mislaid but that the parties interested were present and bore part in the same, and that the above statements are true as I verily believe

Benjamin Polley Flagman
 Jeff. Farr Chain
 Wm. Pally Markers } sworn Deputy M. C. S.
 Geo. B. Rader